IREDELL COUNTY HEALTH DEPARTMENT

STATESVILLE 704-878-5305 MOORESVILLE 704-664-3281

IMPROVEMENT PERMIT / AUTHORIZATION TO CONSTRUCT / OPERATION PERMIT / EXISTING SYSTEM INSPECTION

PERMIT# 071839 PIN# 4634 98 7633 DATE 2/27/98

OWNER OR CONTRACTOR Wilson Properties PHONE: Business MANLEY 895-3672 Home

ADDRESS 190 Wilson Park Rd. Mooresville NC. 28115

LOCATION Langtree Rd. TL 1st Knoxview Dr. on (R) at lake

SUBDIVISION Kiwp Landing BLOCK / SECTION LOT 60 LOT AREA .58 SITE CLASS. PS DESIGN FLOW 360 L.T.A.R. .25-.3

Septic Tank: 1000 Gallons; STB 794 Date 8/24/94
Pump Tank: Gallons; PT Date
Pump Make: Model 900 Serial No. 300
Nitrification Field: No Fields 1 Square Feet ~~720~~ Linear Feet ~~240~~
No Lines 5@60' Trench Width 36" Max Trench Bottom Depth 36" Gravel Depth SAND.

[X] New System ☐ Repair System Type: I, II, (III) IV, V, VI
System Description: GRAVITY-TYPE 3
Repair System Description: ~~SAME~~ Panel Blk
Maintenance Agreement Required: ☐ Yes ☐ No


[X] House/Mod. Home No. Bedrooms 3
☐ Mobile Home No. Bathrooms 2.5
☐ Business No. Employees
☐ Other
☐ Slab ☐ Crawl Space ☐ Basement w/plumbing ☐ Basement wo/plumbing

Water Supply: ☐ Individual ☐ Public [X] Community


Comments:/Conditions: 11/25/98 Talked with Inspections - House has Building Permit for 3 Bedrooms. Walk-thru of House Found 5 Rooms with Closets, Bldg plans Showed 3 Bedrooms, Attic Storage Area & Rec. Room.

Comments:/Conditions: Installed 5-60 lines w/25% Reduction

INITIAL SITE SKETCH

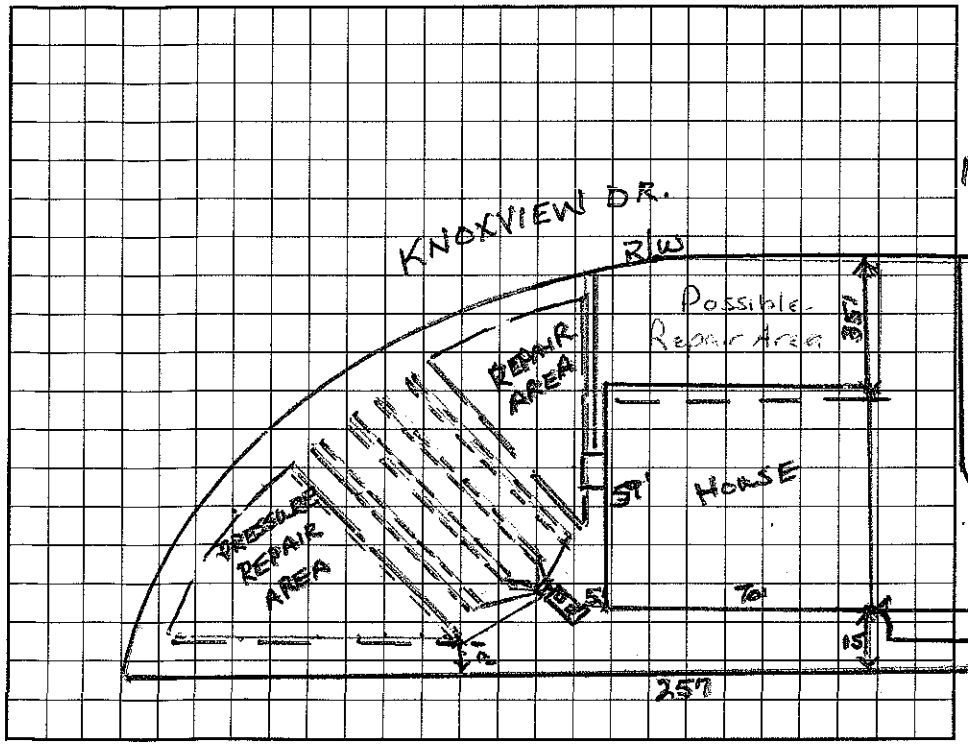

AS BUILT SKETCH

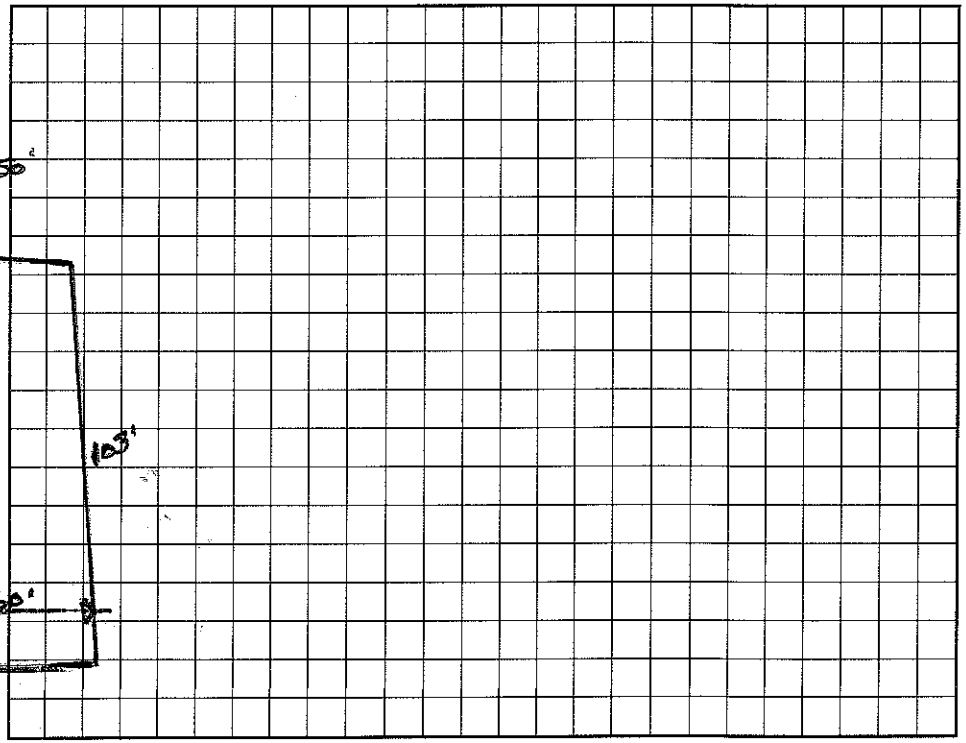

I understand that this permit can be suspended or revoked if any false information is supplied toward securing the permit/any unauthorized changes are made to the site/any unauthorized changes are made in the installation of the system. Improvement Permit with plat valid without expiration. Improvement Permit with site plan valid for sixty months. Authorization to Construct is valid for a period equal to that of Improvement Permit – not to exceed sixty months.

Signed: [signature] date 3/2/98
Improvement Permit by: Wesley Sparks R.S. date 2/27/98
Authorization to Construct by: Wesley Sparks R.S. date 2/27/98

Installed by: E.J. ERVIN
Operation Permit by: [signature] R.S. date 11/25/98
Existing System Inspection by: date

HEALTH DEPT. COPY: WHITE INSPECTION COPY (FINAL): GREEN OWNER COPY (FINAL): YELLOW INSPECTION COPY (INITIAL): PINK OWNER COPY (INITIAL): GOLD