IREDELL COUNTY HEALTH DEPARTMENT

STATESVILLE 704-878-5305 MOORESVILLE 704-664-5281

IMPROVEMENT PERMIT / CERTIFICATE OF COMPLETION / OPERATION PERMIT / EXISTING SYSTEM INSPECTION

PROPERTY DESCRIPTION NO. 21183 DATE 5/22/95 TAX MAP NO. 2B 5 B 61 Watershed: ☐ Yes ☑ No

OWNER OR CONTRACTOR C Richard Dobson / Bob Danbeek PHONE: Business 548-0067 Home

ADDRESS 8220 University Exec Park Charlotte, NC.

LOCATION Knox view Ln. on (R) at Lake 4634-98-8652

SUBDIVISION Kings Landing BLOCK / SECTION LOT 61 LOT AREA ~.62AC SITE CLASS. P DESIGN FLOW 360 L.T.A.R. .3

Septic Tank: 1000 Gallons; STB 794 Date 4/28/95

Pump Tank: Gallons; PT Date

Pump Make: Model Serial No.

Nitrification Field: No Fields 1 Square Feet 1200 Linear Feet * 300

No Lines 4 Trench Width 36" Max Trench Bottom Depth 36" Gravel Depth N/A

☑ New System ☐ Repair System Type: I, II, (III) IV, V, VI

System Description: GRAVITY - INFILTRATOR

Repair System Description: SAME

Maintenance Agreement Required: ☐ Yes ☑ No

☐ Slab ☑ Crawl Space ☐ Basement w/plumbing ☐ Basement wo/plumbing

☑ House/Mod. Home No. Bedrooms 3

☐ Mobile Home No. Bathrooms 3

☐ Business No. Employees


☐ Other

Water Supply: ☐ Individual ☑ Community ☐ Public

Comments: * .25 reduction for infiltrator use

Comments:

INITIAL SITE SKETCH

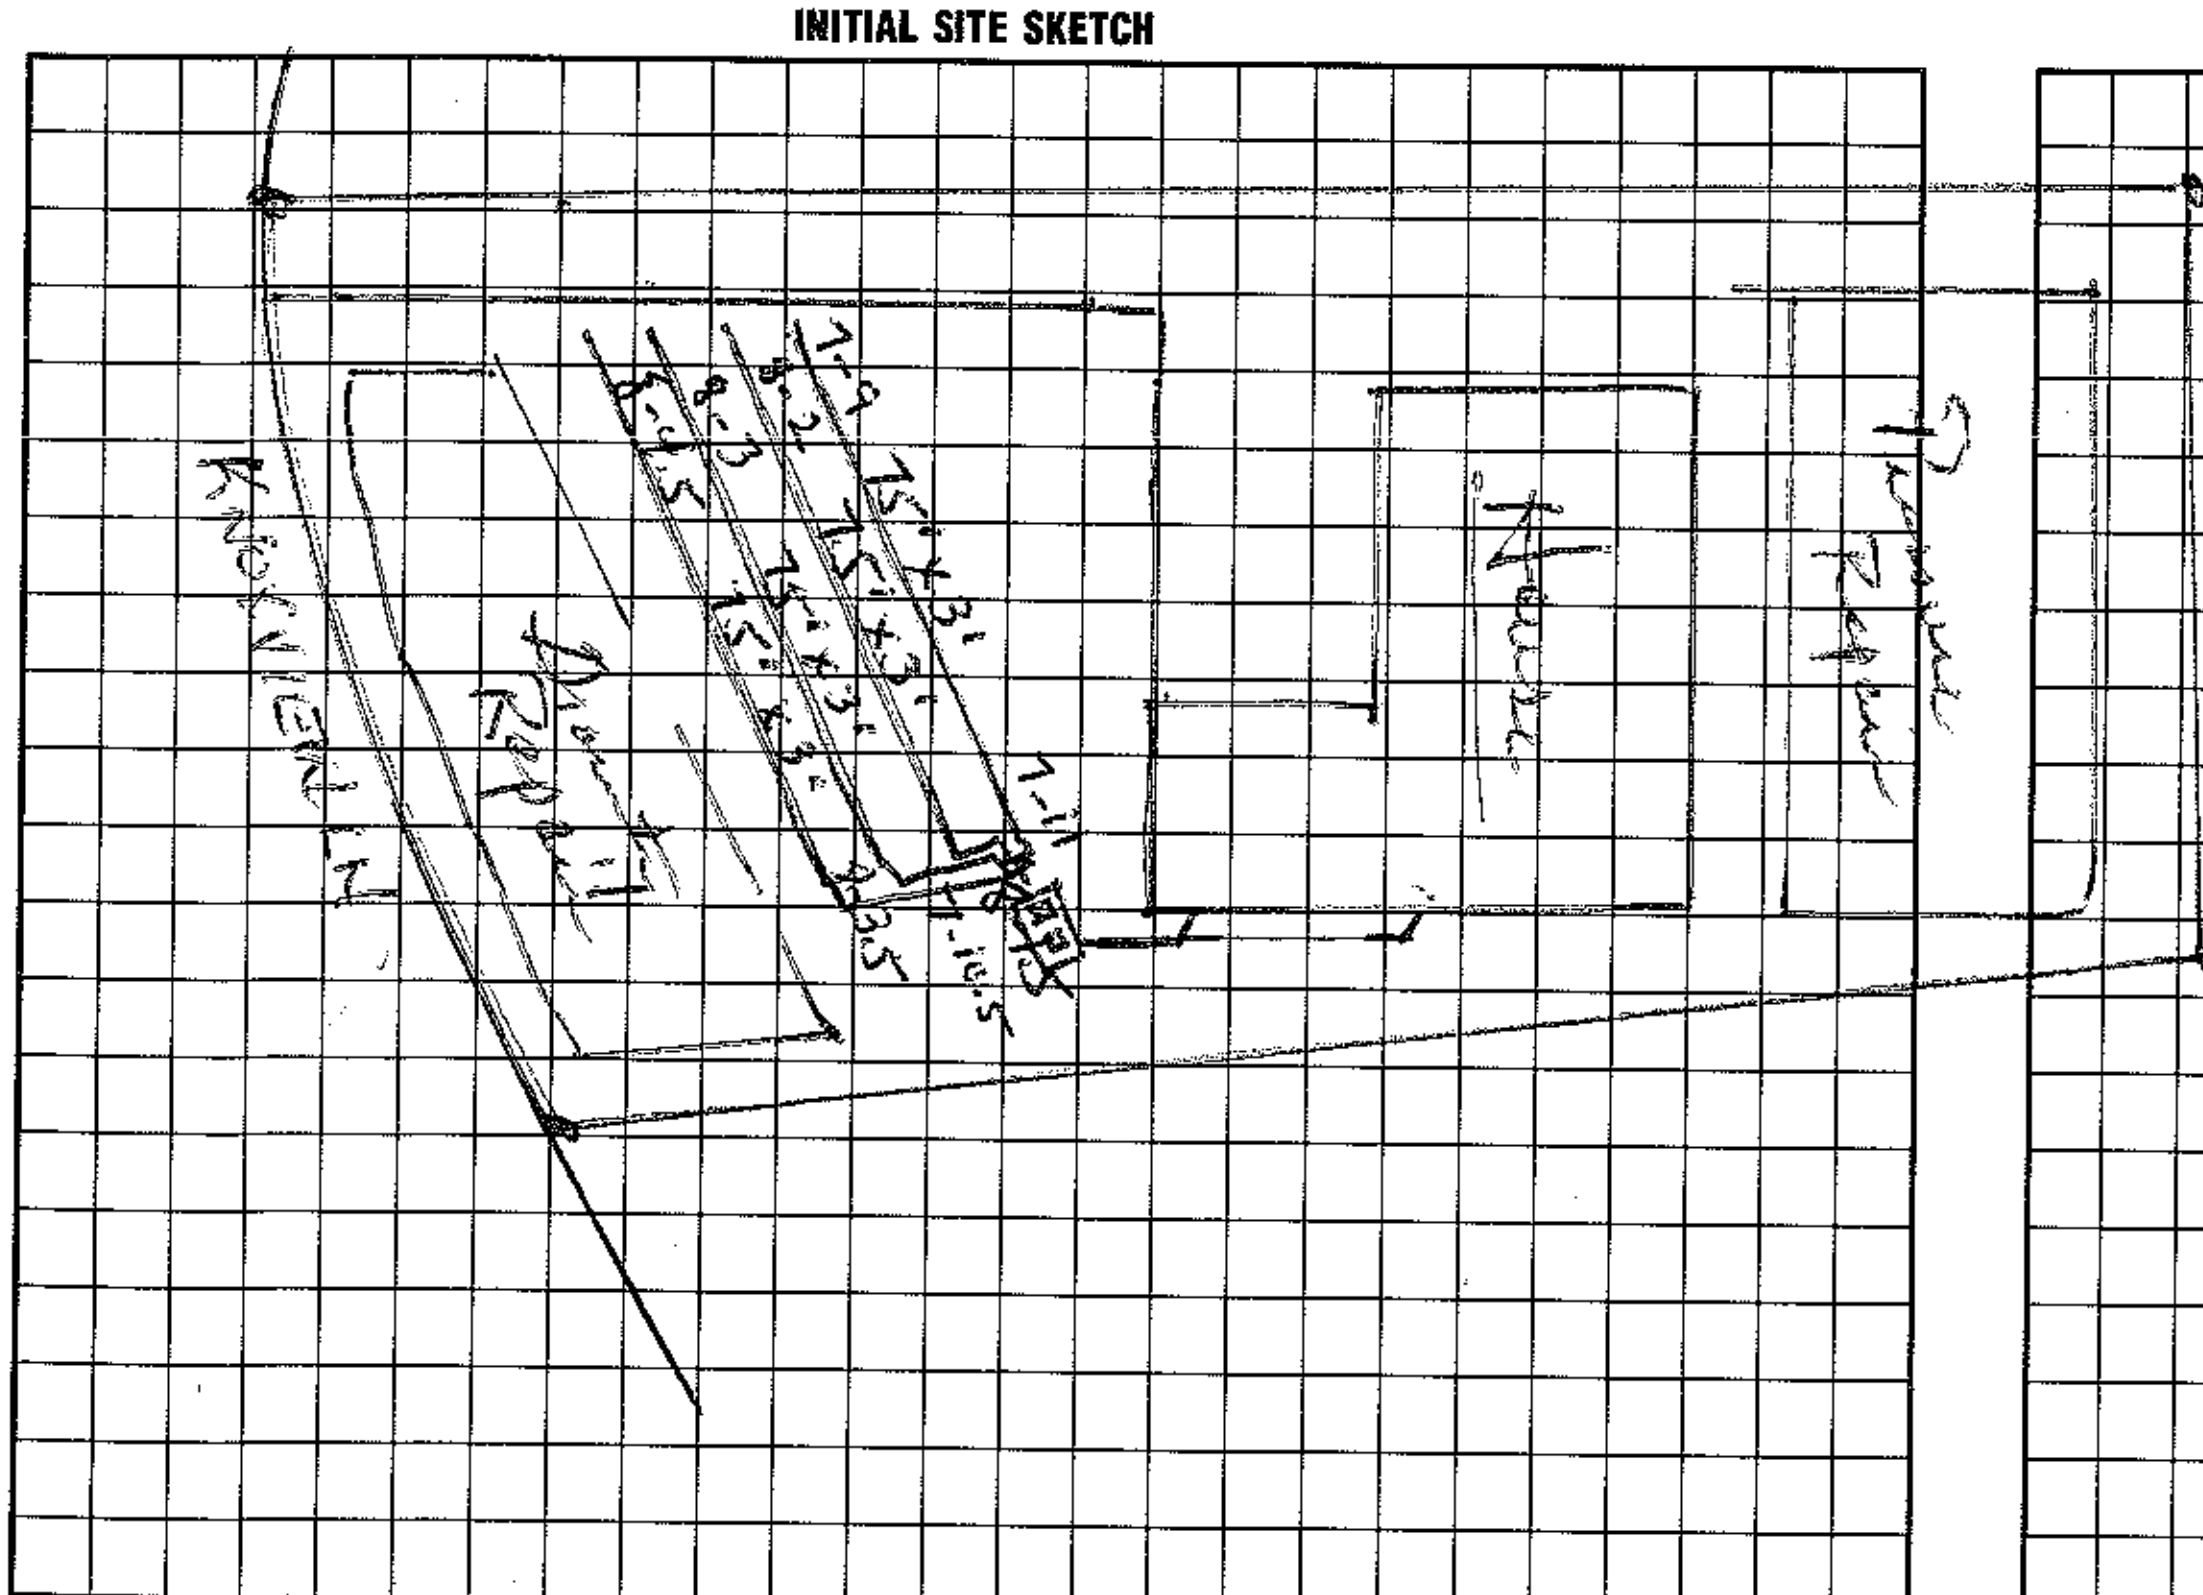

AS BUILT SKETCH

The proposed / existing Deck 14'X26' addition does not appear to impact the existing septic system.

**NOTE: Deck can't exceed size shown due to Repair Area.

[signature] R.S.

Date: 3/28/2012

ICHD-Environmental Health Division

I understand that this permit can be suspended or revoked if any false information is supplied toward securing the permit/any unauthorized changes are made to the site/any unauthorized changes are made in the installation of the system. Improvement Permit is valid for 60 months from date of issuance.

Signed: [signature]

Improvement Permit by: Wesley Sparks R.S. date 5/22/95

Existing System Inspection by: date

Installed by: Bob Mayhew

Certificate of Completion by: Wesley Sparks R.S. date 10/19/95

Operation Permit by: Wesley Sparks R.S. date 10/19/95

HEALTH DEPT. COPY: WHITE INSPECTION COPY (FINAL): GREEN OWNER COPY (FINAL): YELLOW INSPECTION COPY (INITIAL): PINK OWNER COPY (INITIAL): GOLD