IREDELL COUNTY HEALTH DEPARTMENT

STATESVILLE 704-878-5305 MOORESVILLE 704-664-5281

IMPROVEMENT PERMIT / AUTHORIZATION TO CONSTRUCT / OPERATION PERMIT / EXISTING SYSTEM INSPECTION

PERMIT# 149100 PIN# 4634988801 DATE 3-17-08

OWNER OR APPLICANT Diane Parks PHONE: Business 704-577-4630 Home

ADDRESS 1050 Clarendon Pt Court, Huntersville NC 28078

LOCATION Langtree Pl 2nd Knoxview, on left before curve (244)

SUBDIVISION Kings Landing BLOCK / SECTION LOT 59 LOT AREA .67Ac SITE CLASS. PS DESIGN FLOW 480 L.T.A.R. .35

Septic Tank: Gallons: STB Date

Pump Tank: 1000 Gallons: PT Date

Pump Make: Model Serial No.

Nitrification Field: No Fields 1 Square Feet 285 Linear Feet 95'

No Lines 1 Trench Width 36" Max Trench Bottom Depth 36" Gravel Depth 12" ☐ Gravity ☒ Pressure

☐ New System ☐ Repair ☒ Expansion System Type: I, II, (III), IV, V, VI

System Description: PM Conventional

Repair System Description: PPRPS

Maintenance Agreement Required: ☐ Yes ☒ No

☒ House/Mod. Home ☐ Mobile Home ☐ Business ☐ Other

No. Bedrooms 4 No. Persons No. Employees

Water Supply: ☐ Individual ☐ Public ☒ Community

☐ Slab ☒ Crawl Space ☐ Basement w/plumbing ☐ Basement wo/plumbing

Comments:/Conditions: The lowest existing line must be abandoned. New line must be installed (as shown) New pump tank must be installed.

Comments:/Conditions:

INITIAL SITE SKETCH

See Attached Plan from Michael Athanas & Associates

AS BUILT SKETCH

Permit can be suspended or revoked if any false information is supplied toward securing the permit/any unauthorized changes are made to the site/any unauthorized changes are made in the installation of the system. Improvement Permit with plat valid without expiration ☐ Improvement Permit with site plan valid for sixty months ☒ Authorization to Construct is valid for a period equal to that of Improvement Permit – not to exceed sixty months.

Signed: Diane Parks date 3/24/08

Improvement Permit by: J-A Ellis date 3-17-08


Authorization to Construct by: J-A Ellis date 3-17-08

Installed by: Joe Thompson

Operation Permit by: Wesley Sparks RS date 6/20/08

Existing System Inspection by: date

HEALTH DEPT. COPY: WHITE OWNER COPY (FINAL): YELLOW OWNER COPY (INITIAL): PINK

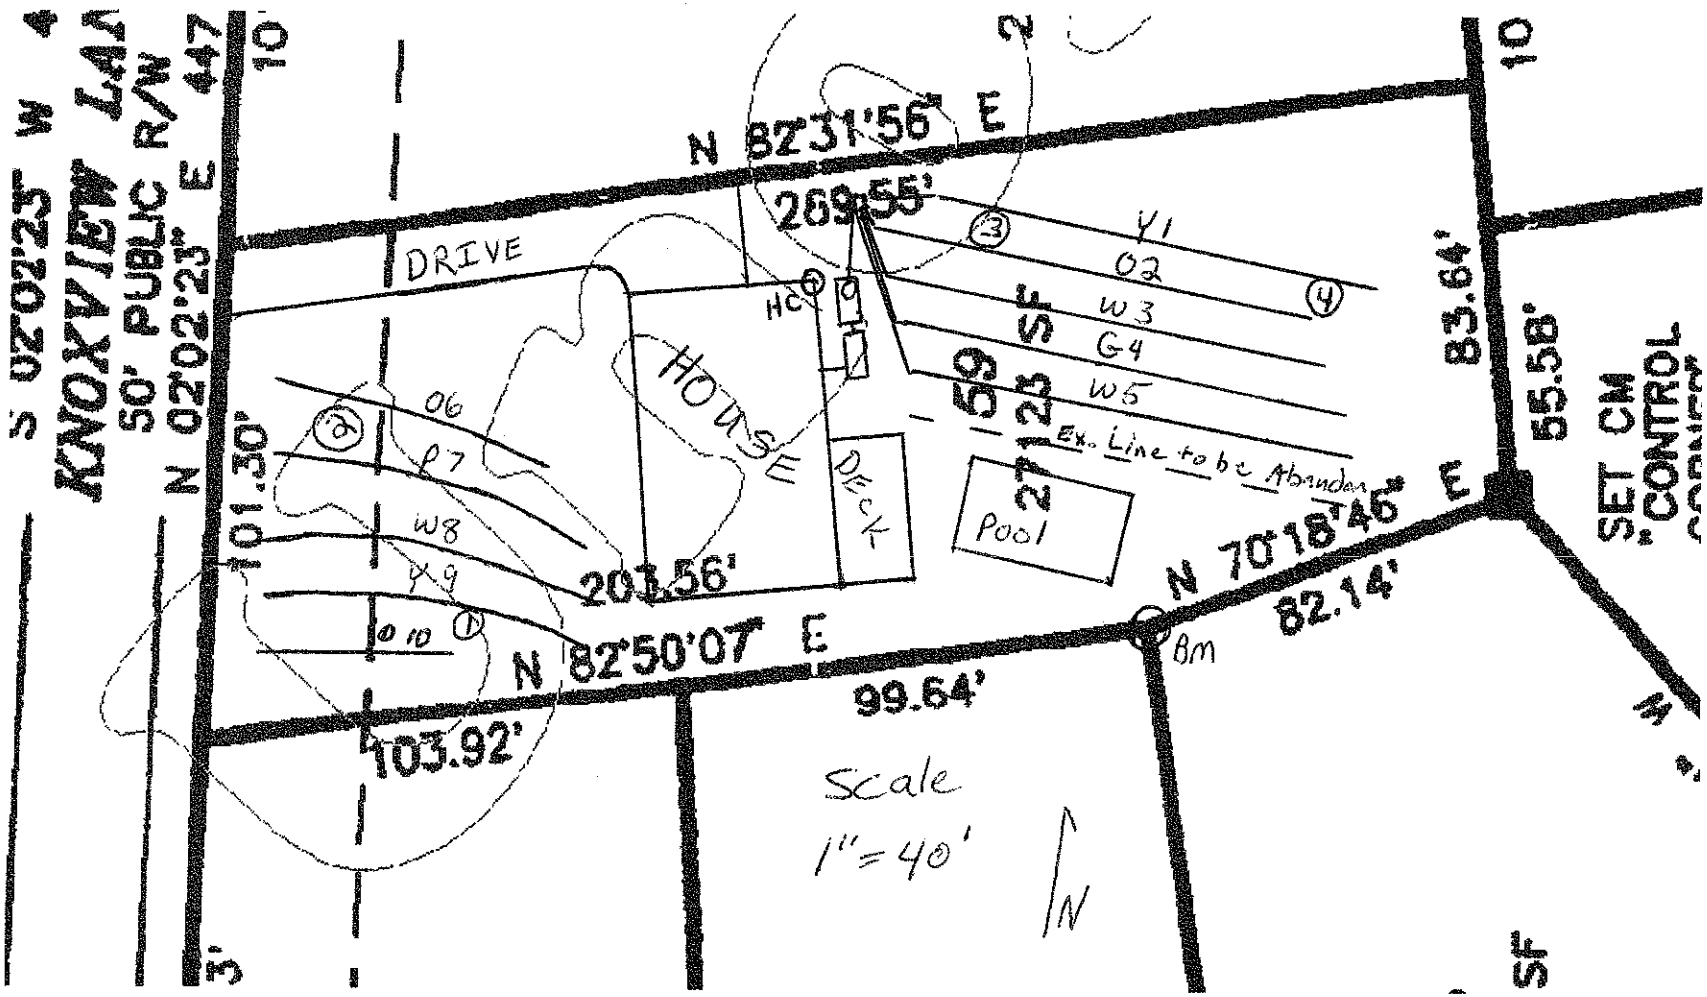

Book:24,Page:149