704-875-1785

IREDELL COUNTY HEALTH DEPARTMENT

Paid 50.00 Redraw

STATESVILLE 704-878-5305 — MOORESVILLE 704-664-5281

IMPROVEMENT PERMIT / AUTHORIZATION TO CONSTRUCT / OPERATION PERMIT / EXISTING SYSTEM INSPECTION

PERMIT# 091458 PIN# 4634 98 8801 DATE 8/8/00

OWNER OR CONTRACTOR Manley Custom Homes PHONE: Business 704-895-3672 Home

ADDRESS 19809 B North Cove Rd. S103

LOCATION Langtree (L) 2nd Knollview on (L) before curve

SUBDIVISION Kings Landing BLOCK / SECTION LOT 59 LOT AREA .62 AC. SITE CLASS. PS DESIGN FLOW 480 L.T.A.R. .35

Septic Tank: 1000 Gallons; STB 312 Date 1/6/01

Pump Tank: Gallons; PT Date

Pump Make: Model Serial No.

Nitrification Field: No Fields 1 Square Feet 1371 Linear Feet 460

No Lines 5@95' Trench Width 36" Max Trench Bottom Depth 36" Gravel Depth 12"

[X] New System [ ] Repair System Type: I (II) III, IV, V, VI

System Description: CONVENTIONAL

Repair System Description: SAME

Maintenance Agreement Required: [ ] Yes [X] No

[X] House/Mod. Home No. Bedrooms 4

[ ] Mobile Home No. Bathrooms 3

[ ] Business No. Employees

[ ] Other


[ ] Slab [X] Crawl Space [ ] Basement w/plumbing [ ] Basement wo/plumbing

Water Supply: [ ] Individual [ ] Public [X] Community


Comments:/Conditions:

Comments:/Conditions:

INITIAL SITE SKETCH (1" = 40')

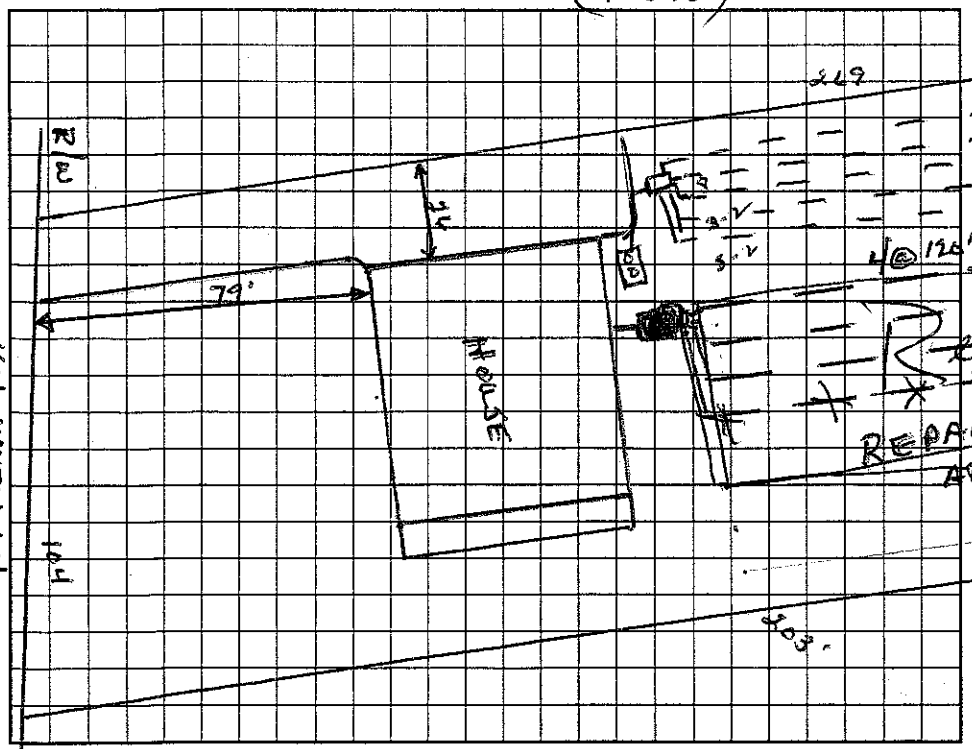

AS BUILT SKETCH

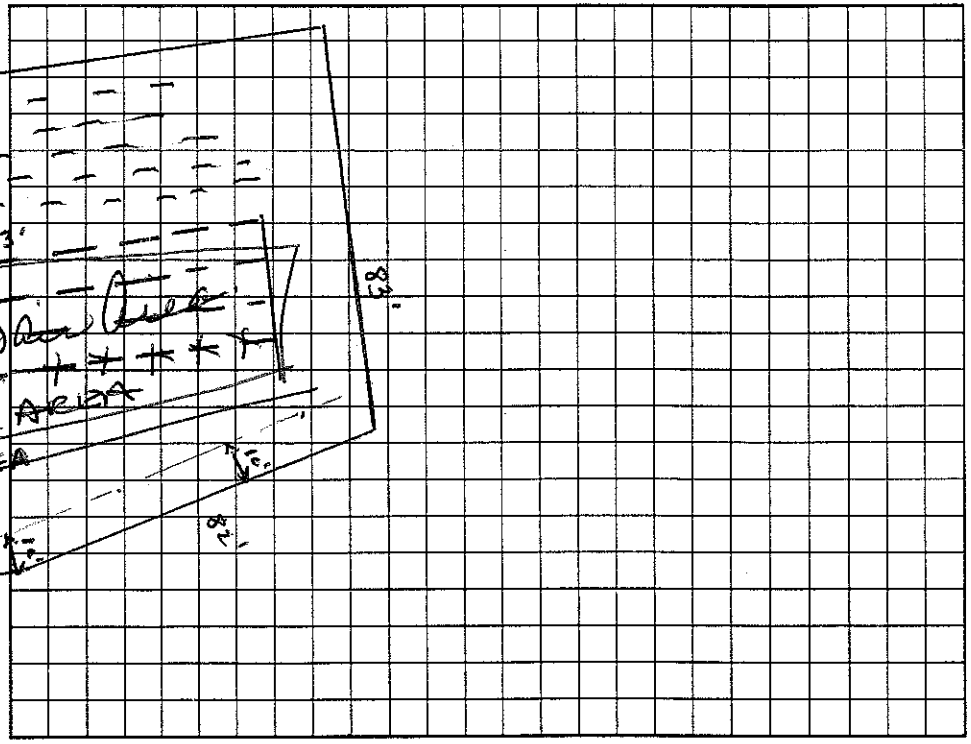

Permit can be suspended or revoked if any false information is supplied toward securing the permit/any unauthorized changes are made to the site/any unauthorized changes are made in the installation of the system. Improvement Permit with plat valid without expiration. Improvement Permit with site plan valid for sixty months. Authorization to Construct is valid for a period equal to that of Improvement Permit – not to exceed sixty months.

Signed: * Thomas Manley date 8/8/00

Improvement Permit by: Wesley Sparks R.S. date 8/8/00

Authorization to Construct by: Wesley Sparks R.S. date 8/8/00

Installed by: F J Erwin

Operation Permit by: Wesley Sparks R.S. date 3/26/01

Existing System Inspection by: date

HEALTH DEPT. COPY: WHITE OWNER COPY (FINAL): YELLOW OWNER COPY (INITIAL): PINK