IREDELL COUNTY HEALTH DEPARTMENT

STATESVILLE 704-878-5305 MOORESVILLE 704-664-5281

IMPROVEMENT PERMIT / AUTHORIZATION TO CONSTRUCT / OPERATION PERMIT / EXISTING SYSTEM INSPECTION

PERMIT# 071062 PIN# 4634989304 DATE 7/2/98

OWNER OR CONTRACTOR WAYNE JESEL PHONE: Business _____ Home 7322293360

ADDRESS 35 MANN CT MONMOUTH NJ 07750

LOCATION LANGTREE - TL KNOXVIEW - AFTER CURVE ON LT.

SUBDIVISION KINGS LANDING BLOCK / SECTION _____ LOT 11 LOT AREA .77AC SITE CLASS. PS DESIGN FLOW 360GPD L.T.A.R. .30PD/FT

Septic Tank: 1000 Gallons; STB 794 Date 2/19/99

Pump Tank: 1000 Gallons; PT 29 Date 4/3/99

Pump Make: MYERS Model ME3E-11 Serial No. 499

Nitrification Field: No Fields 1 Square Feet 900 Linear Feet 300

No Lines 4@75' Trench Width 36" Max Trench Bottom Depth 36" Gravel Depth N/A

☑ New System ☐ Repair System Type: I, II, (III), IV, V, VI

System Description: PUMP CHAMBERS OR HDS

Repair System Description: PUMP PANEL

Maintenance Agreement Required: ☐ Yes ☑ No

☑ House/Mod. Home No. Bedrooms 3

☐ Mobile Home No. Bathrooms 2

☐ Business No. Employees ____

☐ Other _____


☐ Slab ☑ Crawl Space ☐ Basement w/plumbing ☐ Basement wo/plumbing

Water Supply: ☐ Individual ☐ Public ☑ Community

Comments:/Conditions:

Comments:/Conditions:

INITIAL SITE SKETCH 1"=60'

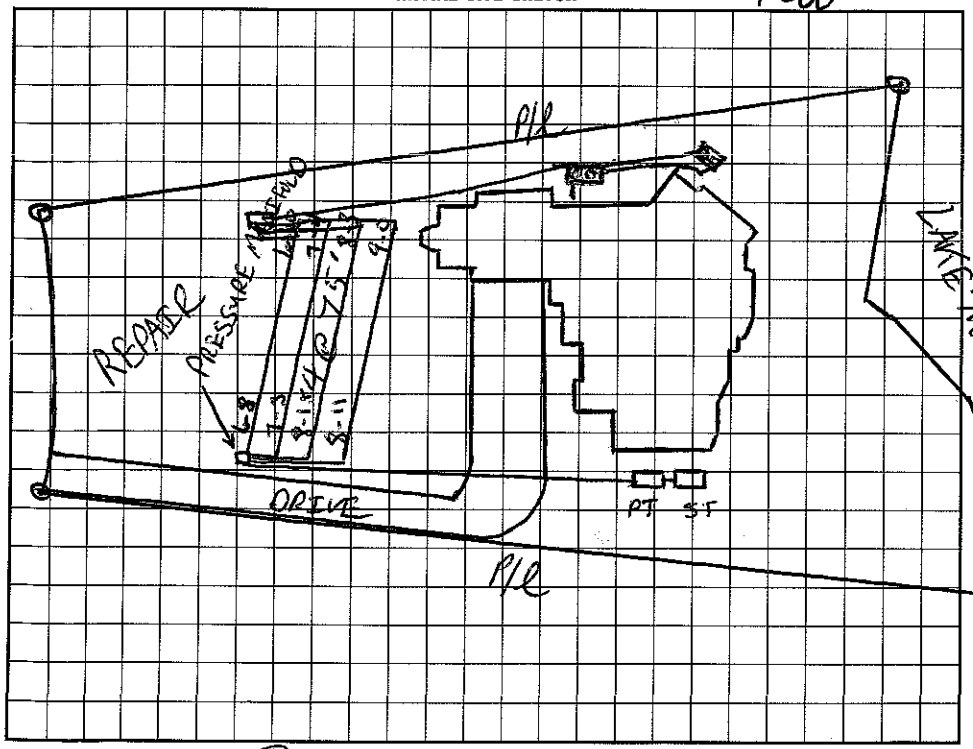

AS BUILT SKETCH

I understand that this permit can be suspended or revoked if any false information is supplied toward securing the permit/any unauthorized changes are made to the site/any unauthorized changes are made in the installation of the system. Improvement Permit with plat valid without expiration. Improvement Permit with site plan valid for sixty months. Authorization to Construct is valid for a period equal to that of Improvement Permit – not to exceed sixty months.

Signed: _____ date _____

Improvement Permit by: C. Ray Zoeller RS date 7/2/98

Authorization to Construct by: C. Ray Zoeller RS date 7/2/98

Installed by: Bob Mayhew

Operation Permit by: Wesley Sparks RS date 11/15/99

Existing System Inspection by: _____ date _____

HEALTH DEPT. COPY: WHITE INSPECTION COPY (FINAL): GREEN OWNER COPY (FINAL): YELLOW INSPECTION COPY (INITIAL): PINK OWNER COPY (INITIAL): GOLD