IREDELL COUNTY HEALTH DEPARTMENT

STATESVILLE 704-878-5305 $5 OORESVILLE 704-664-5281

IMPROVEMENT PERMIT / AUTHORIZATION TO CONSTRUCT / OPERATION PERMIT / EXISTING SYSTEM INSPECTION

PERMIT# 120174 PIN# 4634 98 9668 DATE 5/5/04

OWNER OR CONTRACTOR Jeff Blair PHONE: Business 704-896-6374 Home

ADDRESS 165 Carson Pl. Mooresville, NC 28117

LOCATION 115 S to Langtree TL 1st Knollview, property on (R) at lake

SUBDIVISION Kings Landing BLOCK / SECTION LOT 62 LOT AREA .58Ac SITE CLASS PS DESIGN FLOW 480 L.T.A.R. .3

Septic Tank: 1000 Gallons; STB 1012 Date 11/11/03
Pump Tank: 1000 Gallons; PT 17 Date 7/27/04
Pump Make: Gould Model WE0311M Serial No.
Nitrification Field: No Fields 1 Square Feet 534/801 Linear Feet 267
No Lines 4@67 Trench Width 2-3' Max Trench Bottom Depth 3'

[X] New System [ ] Repair System Type: I, II, III, (IV) V, VI
System Description: Pressed - 16" PPBAS
Repair System Description: Same
Maintenance Agreement Required: [X] Yes [ ] No
Gravel Depth NA


[X] House/Mod. Home No. Bedrooms 4
[ ] Mobile Home No. Bathrooms 4
[ ] Business No. Employees
[ ] Other
[ ] Slab [X] Crawl Space [ ] Basement w/plumbing [ ] Basement wo/plumbing

Water Supply:
[ ] Individual
[ ] Public
[X] Community

Comments:/Conditions: 2' on 8' Centers - 3' on 9' Centers. Lines may be lengthened to 80' if contractor prefers to.

Comments:/Conditions: Lines, tanks & pressure checked by W. Sparks. Elect & alarm checked by MD

INITIAL SITE SKETCH

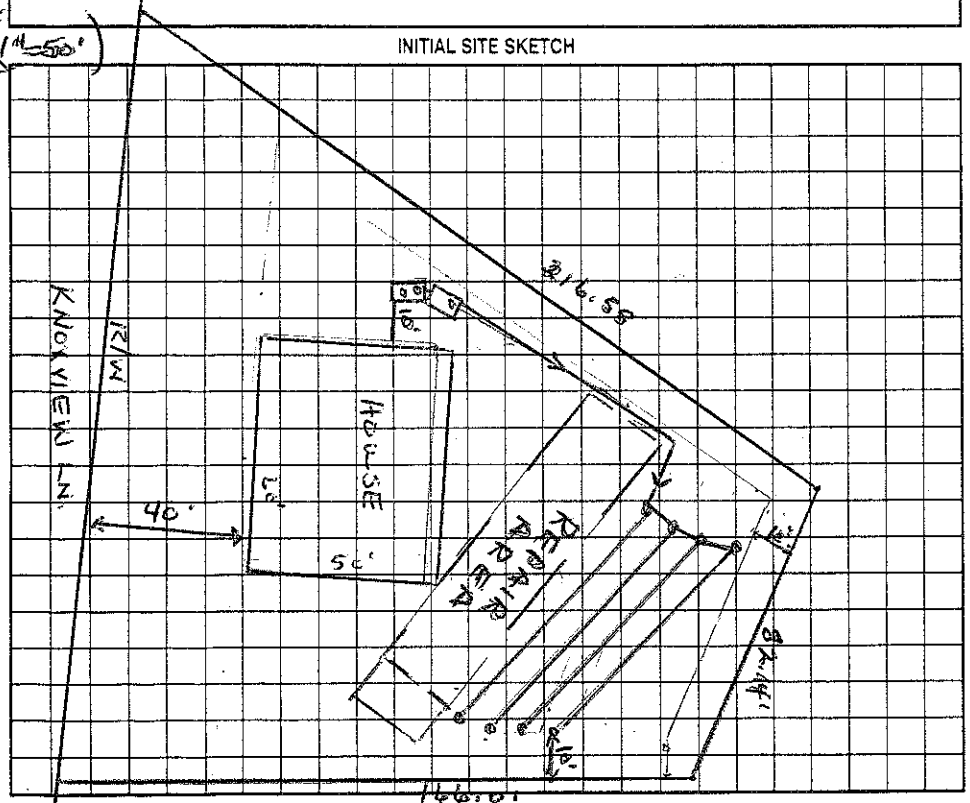

AS BUILT SKETCH

Permit can be suspended or revoked if any false information is supplied toward securing the permit/any unauthorized changes are made to the site/any unauthorized changes are made in the installation of the system. Improvement Permit with plat valid without expiration. Improvement Permit with site plan valid for sixty months. Authorization to Construct is valid for a period equal to that of Improvement Permit – not to exceed sixty months.

Signed: Jeff R. Blair date

Improvement Permit by: Wesley Sparks RS date 5/5/04

Authorization to Construct by: Wesley Sparks RS. date 5/5/04

Installed by: Craig Thompson

Operation Permit by: Marvin Dotson R.S. date 8/29/05

Existing System Inspection by: date

HEALTH DEPT. COPY: WHITE OWNER COPY (FINAL): YELLOW OWNER COPY (INITIAL): PINK