IREDELL COUNTY HEALTH DEPARTMENT

STATESVILLE 704-878-5305 375.00 Paid MOORESVILLE 704-664-5281

IMPROVEMENT PERMIT / AUTHORIZATION TO CONSTRUCT / OPERATION PERMIT / EXISTING SYSTEM INSPECTION

PERMIT# 112629 PIN# 4634 99 0972 DATE 5/30/03

OWNER OR CONTRACTOR Stephen Dallant PHONE: Business 704-896-8400 Home

ADDRESS 21407 Rosslare Ct. Cornelius, NC. 28031

LOCATION 1155 TR Langtree Rd. TL 2nd Knockview TR Kings Crest Dr., 3rd lot on (L)

SUBDIVISION Kings Landing BLOCK / SECTION LOT 33 LOT AREA .62 Ac. SITE CLASS PS DESIGN FLOW 480 L.T.A.R. .3

Septic Tank: 1000 Gallons; STB 825 Date

Pump Tank: 1000 Gallons; PT 308 Date 11/18/04

Pump Make: ZOELLER Model N137 Serial No.

Nitrification Field: No Fields 1 Square Feet 804 Linear Feet 268

No Lines 3/80,88,100 Trench Width 2-(3)' Max Trench Bottom Depth 3' Gravel Depth No

[X] New System [ ] Repair System Type: I. II. III. (IV.) V. VI.

System Description: 16" PPBPS - LP Distribution

Repair System Description: Some

Maintenance Agreement Required: [X] Yes [ ] No

[X] House/Mod. Home No. Bedrooms 4

[ ] Mobile Home No. Bathrooms 3

[ ] Business No. Employees

[ ] Other

[ ] Slab [X] Crawl Space [ ] Basement w/plumbing [ ] Basement wo/plumbing

Water Supply: [ ] Individual [ ] Public [X] Community


Comments:/Conditions: Very tight - No changes possible unless much smaller house is used

MAINTENANCE CONTRACT REQUIRED.


Comments:/Conditions:

(1" = 50')

INITIAL SITE SKETCH

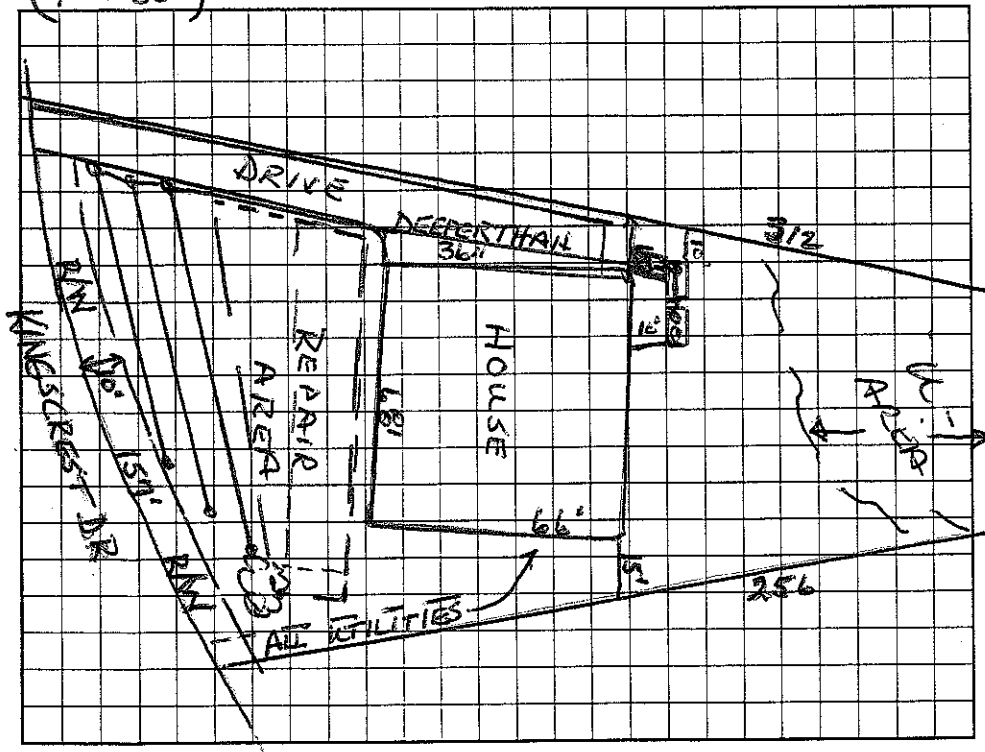

AS BUILT SKETCH

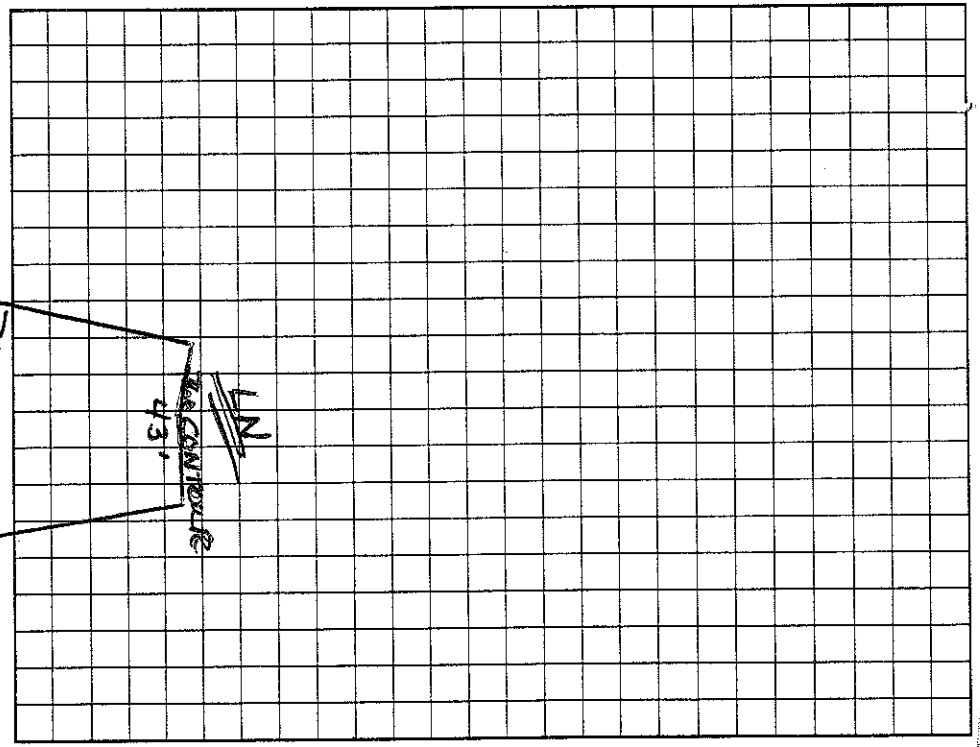

Permit can be suspended or revoked if any false information is supplied toward securing the permit/any unauthorized changes are made to the site/any unauthorized changes are made in the installation of the system. Improvement Permit with plat valid without expiration. Improvement Permit with site plan valid for sixty months. Authorization to Construct is valid for a period equal to that of Improvement Permit – not to exceed sixty months.

Signed: X Stephen C. Gallant date 7.17.03

Improvement Permit by: Wesley Sparks RS. date 5/30/03

Authorization to Construct by: Wesley Sparks RS. date 5/30/03

Installed by: Rowan Septic Tank

Operation Permit by: Wesley Sparks RS. date 6/25/04

Existing System Inspection by: date

HEALTH DEPT. COPY: WHITE OWNER COPY (FINAL): YELLOW OWNER COPY (INITIAL): PINK