IREDELL COUNTY HEALTH DEPARTMENT - *ENVIRONMENTAL HEALTH* ☐ STATESVILLE OFFICE 704-878-5305 ☒ MOORESVILLE OFFICE 704-664-5281

IMPROVEMENT PERMIT / AUTHORIZATION TO CONSTRUCT / OPERATION PERMIT / EXISTING SYSTEM INSPECTION

PERMIT # 173518 PIN # 4634-99-1985 DATE 8-13-12

OWNER BRYAN PEACO APPLICANT: BLUEFIELD BUILDERS PHONE: Home/Cell # 704-652-7674 Business #

SITE ADDRESS 125 KINGS CREST DR. OWNER / APPLICANT ADDRESS 120 STEINBECK WAY MOORESVILLE

SITE DIRECTIONS LANGTREE, TL KNOXVIEW, TR KINGS CREST, ON L

SUBDIVISION ELIZABETH KNOX BLOCK / SECTION LOT # 2 LOT AREA .978 AC DESIGN FLOW 480 L.T.A.R. .3

Septic Tank 1000 Gallons: STB 794 Date 3-1-13

Pump Tank 1000 Gallons: P.T 283 Date 3-1-13

Pump Make GRAVITS Model PESTM Serial #

No. Nitrification Fields: 1 No. Lines 4 Linear Feet 400'

Trench Width 36" Max. Trench Bottom Depth 36" Gravel Depth —

☒ New System ☐ Repair ☐ Expansion System Type I II (IIB) IV V VI

System Description: PM - 25% REDUCTION

Repair System Description: SAME

Maintenance Agreement Required ☐ YES ☒ NO

☐ GRAVITY ☒ PRESSURE

☒ Residence No. Bedrooms 4

☐ Business No. Persons

☐ Other No. Employees

☐ Slab ☒ Crawl Space

☐ Basement w/plumbing ☐ Basement w/o plumbing

Water Supply: ☒ Private ☐ Public ☒ Community

Comments / Conditions

INITIAL SITE SKETCH

SEE ATTACHED DRAWING BY CHD

AS BUILT SKETCH

INSTALLED AS SHOWN
CHECKED LINES & TANKS 4-3-13
~~NEED TO RUN PUMP~~
~~LOOK FOR LINDA IN FILE~~

Permit can be suspended or revoked if any false information is supplied toward securing the permit / any unauthorized changes are made to the site / any unauthorized changes are made in the installation of the system.

☐ ***IMPROVEMENT PERMIT*** *with plat valid without expiration.* ☒ ***IMPROVEMENT PERMIT*** *with plat valid without expiration. site plan valid for one year.* ☒ ***AUTHORIZATION TO CONSTRUCT*** valid for period equal to IMPROVEMENT PERMIT--not to exceed 60 mo.

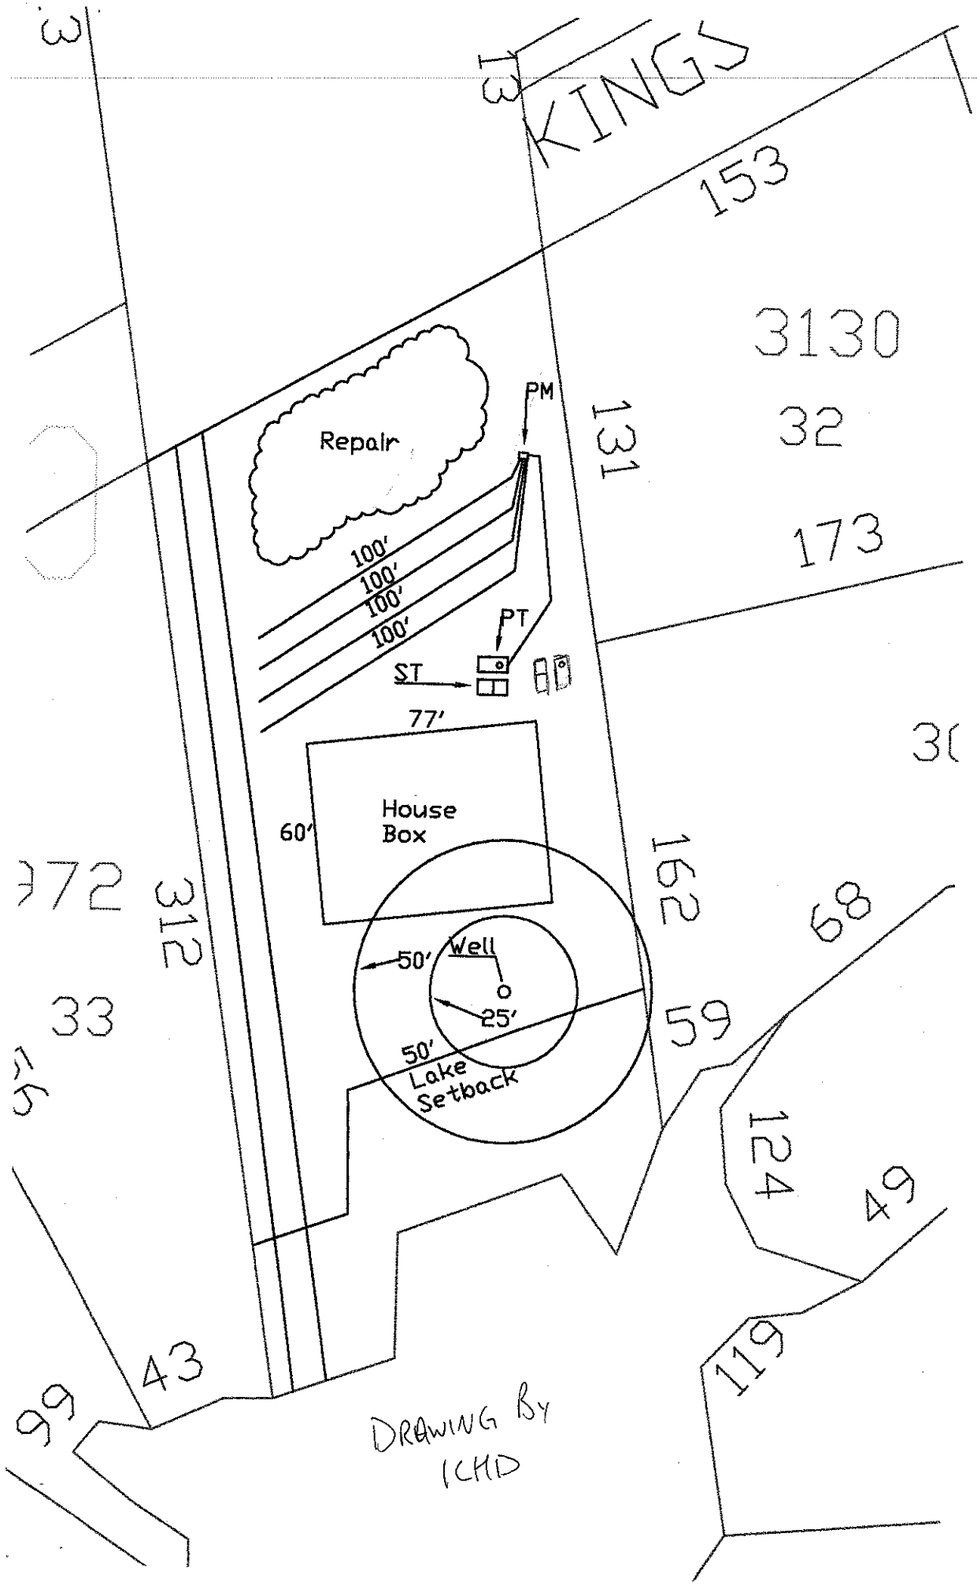
Owner / Applicant Signature: Date 8-24-12 Installed by: RICHARD ARENATHY

IMPROVEMENT PERMIT by: REHS Date 8-13-12 OPERATION PERMIT by: REHS Date 7-2-13

AUTHORIZATION TO CONSTRUCT by: REHS Date 10-9-12 Existing System Inspected by: REHS Date

YOU SHOULD CONTACT A LOCATOR SERVICE PRIOR TO ANY EXCAVATION

White Copy – Environmental Health YELLOW COPY (final) Owner / Applicant PINK COPY (initial) Owner / Applicant


KINGS
153
3130
32
131
173
PM
Repair
100'
100'
100'
100'
PT
ST
77'
House
Box
60'
50'
Well
25'
50'
Lake
Setback
312
162
68
59
124
49
119
43
99
33
DRAWING BY
ICHD