IREDELL COUNTY HEALTH DEPARTMENT

Authorization to Construct

STATESVILLE 704-878-5305 MOORESVILLE 704-664-5281

IMPROVEMENT PERMIT / ~~CERTIFICATE OF COMPLETION~~ / OPERATION PERMIT / EXISTING SYSTEM INSPECTION

PROPERTY DESCRIPTION NO. 22880 DATE 12/22/95 TAX MAP NO. 2B 5 B20 4634 99 4092 Watershed: ☒ Yes ☐ No

OWNER OR CONTRACTOR Richard Dobson Bldrs. PHONE: Business 548-0067 Home

ADDRESS 8220 Lennis Lee Pl Charlotte NC. 28262

LOCATION 255 Knowdview Ln. To ff Longtree Rd.

SUBDIVISION Kings Landing BLOCK / SECTION LOT 20 LOT AREA .679 SITE CLASS. PS DESIGN FLOW 480 L.T.A.R. .3

Septic Tank: 1000 Gallons; STB 794 Date 7/11/96

Pump Tank: 1000 Gallons; PT ~~SEPTIC~~ 27 Date 8/16/96

Pump Make: LIBERTY Model LE51A Serial No. 2413

Nitrification Field: No Fields 1 Square Feet 1600 Linear Feet 488 (533)

No Lines 7 Trench Width 36" Max Trench Bottom Depth 36" Gravel Depth N/A

☒ New System ☐ Repair System Type: I, II, III, IV, V, VI

System Description: Pres flat bottom

Repair System Description: Same

Maintenance Agreement Required: ☐ Yes ☒ No

☒ House/Mod. Home No. Bedrooms 4

☐ Mobile Home No. Bathrooms 3

☐ Business No. Employees

☐ Other


☐ Slab ☐ Crawl Space ☐ Basement w/plumbing ☐ Basement wo/plumbing

Water Supply:
☐ Individual
☒ Community
☐ Public

Comments:


Comments:

INITIAL SITE SKETCH

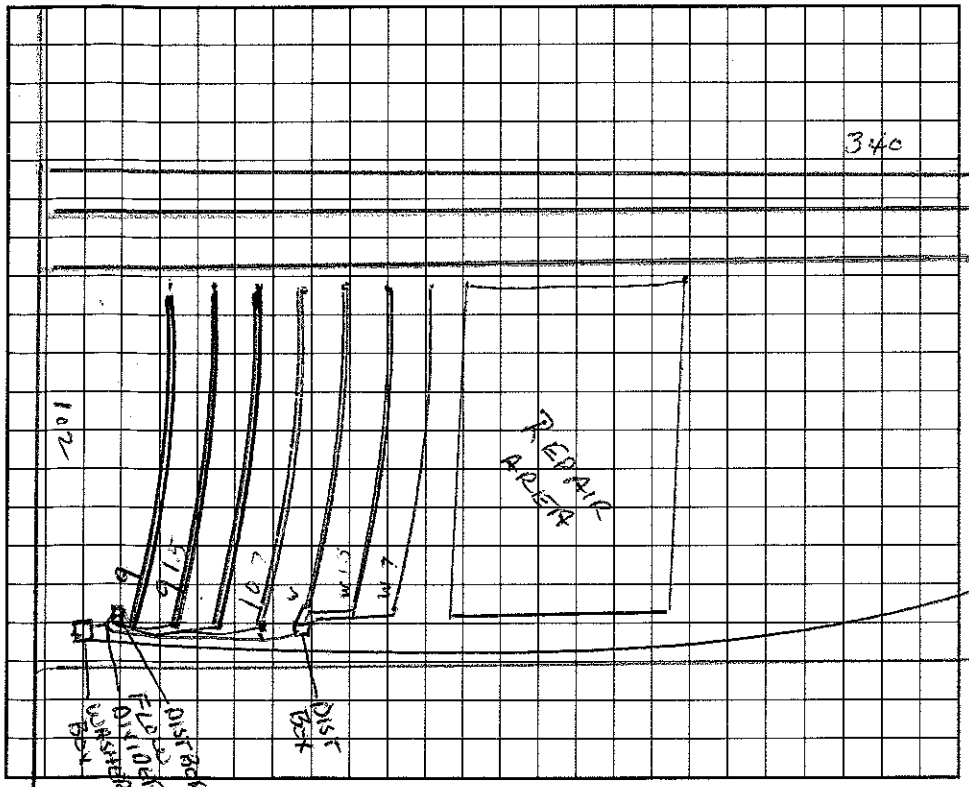

Knowdview Ln.

AS BUILT SKETCH

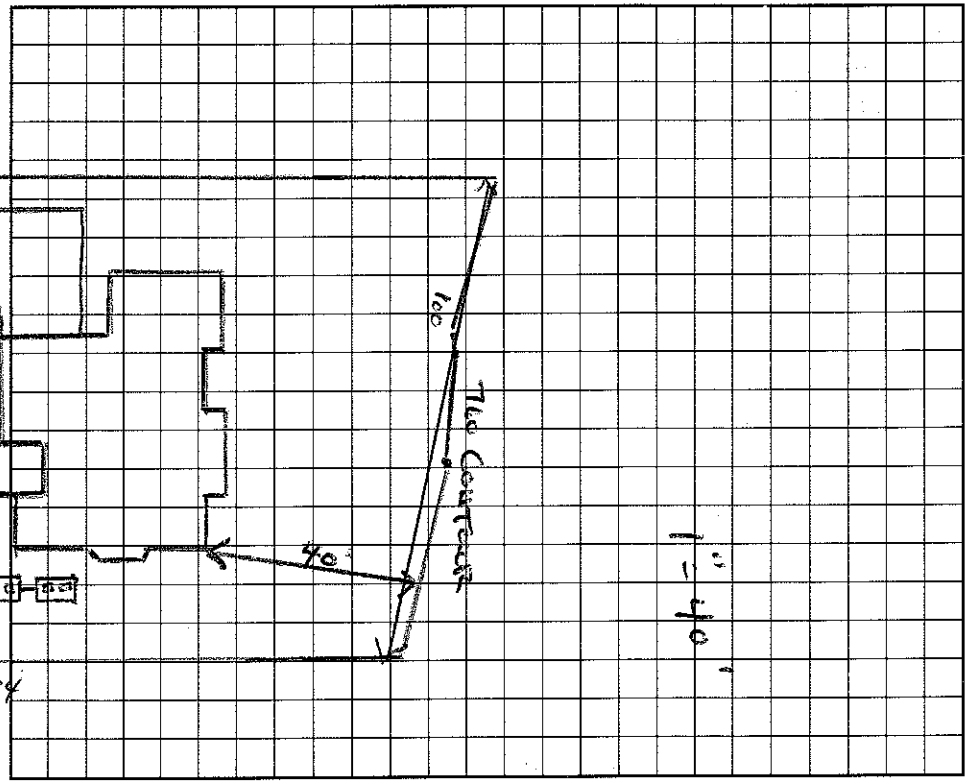

I understand that this permit can be suspended or revoked if any false information is supplied toward securing the permit/any unauthorized changes are made to the site/any unauthorized changes are made in the installation of the system.

Signed:

Improvement Permit by: Wesley Sparks RS. date 12/29/95

Authorization to Construct Existing System Inspection by: Wesley Sparks RS date 12/29/95

Installed by: MAYHEW SEPTIC

Certificate of Completion by: date

Operation Permit by: Wesley Sparks RS. date 10/9/96

HEALTH DEPT. COPY: WHITE INSPECTION COPY (FINAL): GREEN OWNER COPY (FINAL): YELLOW INSPECTION COPY (INITIAL): PINK OWNER COPY (INITIAL): GOLD