IREDELL COUNTY HEALTH DEPARTMENT

STATESVILLE 704-878-5305 MOORESVILLE 704-664-5281

IMPROVEMENT PERMIT / CERTIFICATE OF COMPLETION / OPERATION PERMIT / EXISTING SYSTEM INSPECTION

PROPERTY DESCRIPTION NO. 20183 DATE March 7, 95 TAX MAP NO. part of 2BB2 4634994397 Watershed: ☑ Yes ☐ No

OWNER OR CONTRACTOR Johnson Buildings PHONE: Business _____ Home _____

ADDRESS 8320 University Ex. Park Suite 130, Charlotte WSIV

LOCATION Langtree Road TL Knowlton Lane on Right

SUBDIVISION Langtree Landing BLOCK / SECTION _____ LOT 24 LOT AREA 27167 ft² SITE CLASS. B pre 1996 DESIGN FLOW 480 gpd L.T.A.R. .83

Septic Tank: 1000 Gallons; STB Dellinger 994 Date 4-4-95

Pump Tank: 1000 Gallons; PT Dellinger 27 Date 5-10-95

Pump Make: _____ Model _____ Serial No. _____

Nitrification Field: No Fields 1 Square Feet 1200 Linear Feet 400

No Lines 6 Trench Width 36" Max Trench Bottom Depth 36" Gravel Depth NA

☐ New System ☐ Repair System Type: I, II, III, IV, V, VI

System Description: pump/pressure manifold/Infiltrator

Repair System Description: LS 10835

Maintenance Agreement Required: ☐ Yes ☑ No

☑ House/Mod. Home No. Bedrooms 4

☐ Mobile Home No. Bathrooms 3

☐ Business No. Employees _____

☐ Other _____

☐ Slab ☑ Crawl Space ☐ Basement w/plumbing ☐ Basement wo/plumbing


Water Supply: ☐ Individual ☑ Community ☐ Public

Comments: Infiltrator Laterals 9' o.c.


Comments: Water line installed on right prop. line 10' from septic system

1" = 50'

INITIAL SITE SKETCH

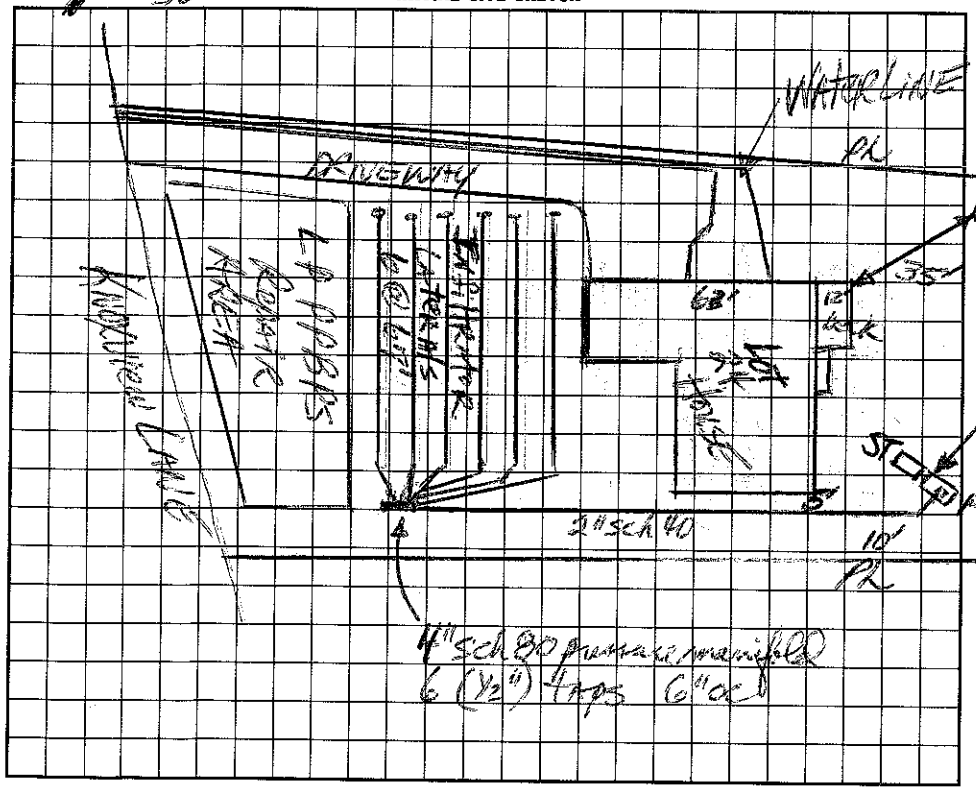

AS BUILT SKETCH

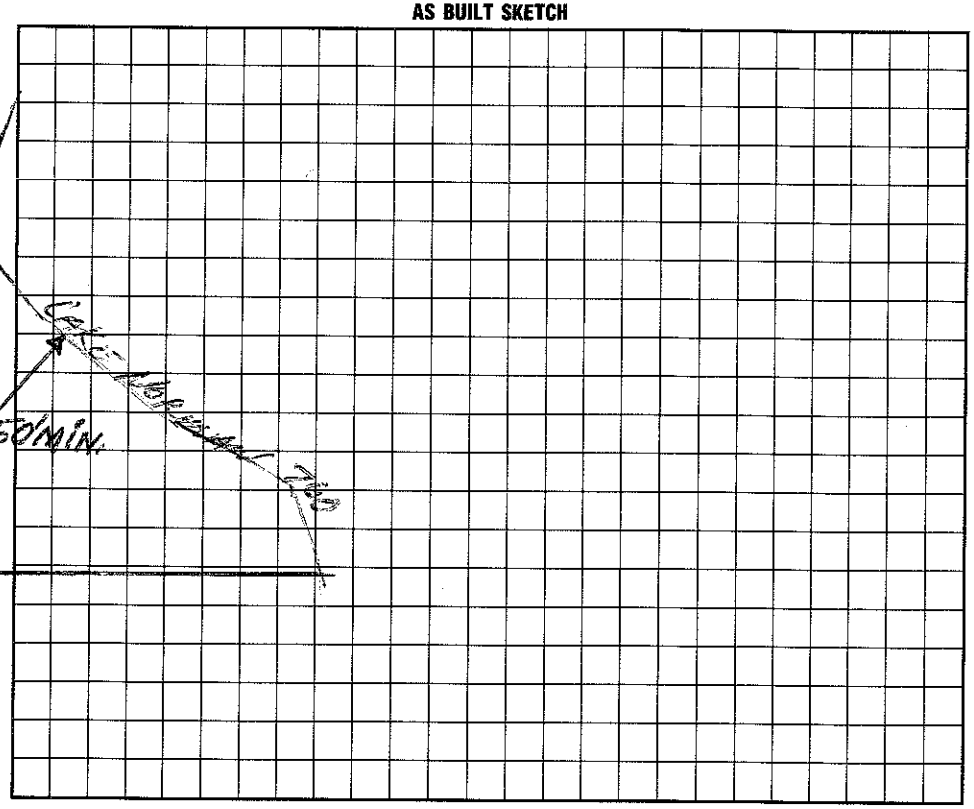

I understand that this permit can be suspended or revoked if any false information is supplied toward securing the permit/any unauthorized changes are made to the site/any unauthorized changes are made in the installation of the system. Improvement Permit is valid for 60 months from date of issuance.

Signed: _____

Improvement Permit by: _____ date 3/7/95

Existing System Inspection by: _____ date _____

Installed by: Bobby Mayhew

Certificate of Completion by: _____ date _____

Operation Permit by: _____ date 7-18-95

HEALTH DEPT. COPY: WHITE INSPECTION COPY (FINAL): GREEN OWNER COPY (FINAL): YELLOW INSPECTION COPY (INITIAL): PINK OWNER COPY (INITIAL): GOLD