IREDELL COUNTY HEALTH DEPARTMENT

STATESVILLE 704-878-5305 MOORESVILLE 704-664-5281

IMPROVEMENT PERMIT / AUTHORIZATION TO CONSTRUCT / OPERATION PERMIT / EXISTING SYSTEM INSPECTION

PERMIT# 106 484 PIN# 4634-99-4728 DATE 10/28/02

OWNER OR CONTRACTOR Kenneth Beaver Homes PHONE: Business 704-662-6400 Home

ADDRESS PO Box 3398 Mooresville NC 28117

LOCATION Langtree, TL 2nd Knox view, on RT

SUBDIVISION Kings Landing BLOCK / SECTION LOT 26 LOT AREA 0.524C SITE CLASS. PS DESIGN FLOW 360 L.T.A.R. 0.3

Septic Tank: 1000 Gallons; STB 1612 Date 8/14/02

Pump Tank: 1000 Gallons; PT 17 Date 5/16/03

Pump Make: Model Serial No.

Nitrification Field: No Fields 1 Square Feet 630 Linear Feet 210

No Lines 3 @ 70' Trench Width 24"-36" Max Trench Bottom Depth 36" Gravel Depth —

☒ New System ☐ Repair System Type: I. II. III. (IV) V. VI

System Description: LP Panel Block

Repair System Description: same

Maintenance Agreement Required: ☒ Yes ☐ No

☒ House/Mod. Home No. Bedrooms 3

☐ Mobile Home No. Bathrooms 2.5

☐ Business No. Employees

☐ Other


☐ Slab ☒ Crawl Space ☐ Basement w/plumbing ☒ Basement wo/plumbing

Water Supply: ☐ Individual ☐ Public ☒ Community


Comments:/Conditions:

Comments:/Conditions: 8/19/03 - Meeting w Treadwell - Tanks located behind garage due to plumbing being too deep. Girder Pump will have to be set in basement & pressured.

INITIAL SITE SKETCH

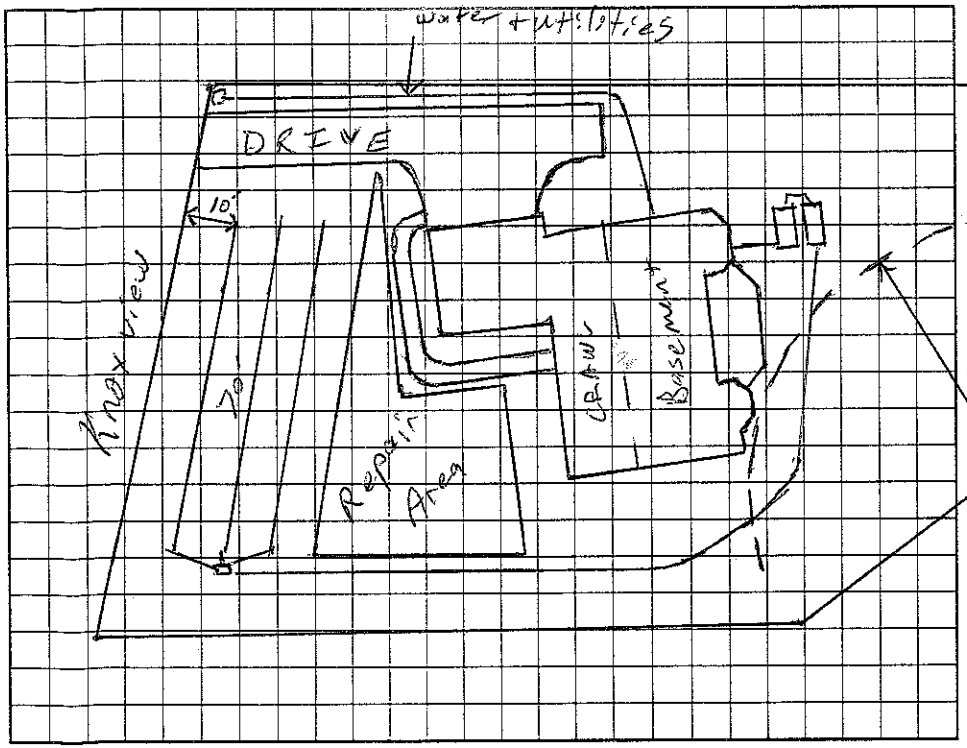

AS BUILT SKETCH

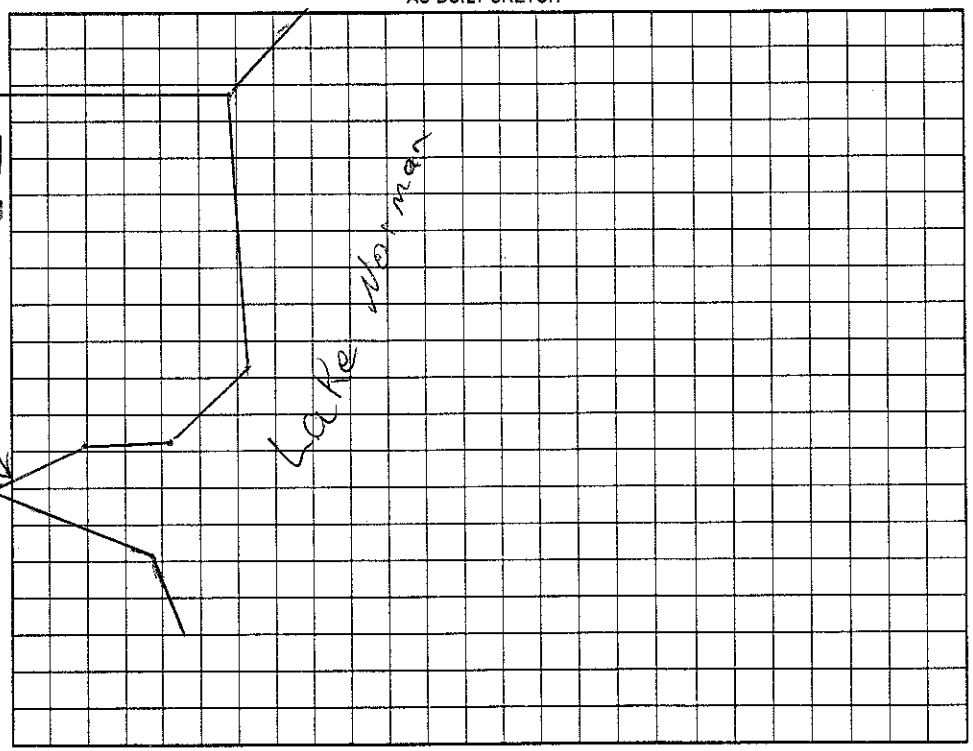

Permit can be suspended or revoked if any false information is supplied toward securing the permit/any unauthorized changes are made to the site/any unauthorized changes are made in the installation of the system. Improvement Permit with plat valid without expiration. Improvement Permit with site plan valid for sixty months. Authorization to Construct is valid for a period equal to that of Improvement Permit – not to exceed sixty months.

Signed: Felicia Bush date 10/29/02 Installed by: Steve Jordan

Improvement Permit by: RS date 10/25/02 Operation Permit by: RS date 9/3/03

Authorization to Construct by: RS date 10/25/02 Existing System Inspection by: date

HEALTH DEPT. COPY: WHITE OWNER COPY (FINAL): YELLOW OWNER COPY (INITIAL): PINK