10130

IREDELL COUNTY HEALTH DEPARTMENT

STATESVILLE 704-878-5305 MOORESVILLE 704-664-5281

IMPROVEMENT PERMIT / AUTHORIZATION TO CONSTRUCT / OPERATION PERMIT / EXISTING SYSTEM INSPECTION

PERMIT # 128454 PIN # 4634 99 4941 DATE 9/28/09

OWNER or APPLICANT DAVID LUCERI PHONE: Business Home: 704-662-3399

OWNER or APPLICANT ADDRESS 142 SARCADIAN WAY MOORESVILLE, NC. 28117

LOCATION / DIRECTIONS I-77 TO LANGTREE RD. TL 2ND KNOXVIEW LN., ON R PAST KINGSCREST DR.

SUBDIVISION KINGS LANDING BLOCK / SECTION 1 LOT # 29+30 LOT AREA ~.93 DESIGN FLOW 480 L.T.A.R. .25

Septic Tank	1000	Gallons: STB	194	Date	3-4-10	☒ New System	☐ Repair	☐ Expansion System	Type I II (III) IV V VI
Pump Tank	1000	Gallons: P.T	27	Date	1-26-11	System Description: ULTRA SHALLOW - PM - 25% REDUCTION			
Pump Make	Goulds	Model	WE013	Serial #		Repair System Description: PRESSURE - DRIP IRRIGATION			
Nitrification Field	No Fields 1	No Lines	5	Linear Feet	500	Maintenance Agreement Required	(YES)	☒ NO	
Trench Width	3'	Max. Trench Bottom Depth	12"	Gravel Depth	NO	☐ GRAVITY	☒ PRESSURE		

☒ Residence	No. Bedrooms	4	Water Supply		
☐ Business	No. Persons		☐ Private		
☐ Other	No. Employees		☐ Public		
☐ Slab	☒ Crawl Space		☒ Community		
☐ Basement w/plumbing	☐ Basement w/o plumbing				


Comments / Conditions

ULTRA SHALLOW 12"
TRENCH BOTTOM - 8" & SUITABLE COVER MATERIAL REQUIRED. X/O CHANGES WITHOUT WRITTEN AUTHORIZATION FROM ICHD. - UPSLOPE INTERCEPT DRAIN REQUIRED


Comments / Conditions

6" gravel around pipe in "Farm Drain" 12" trench bottom 8-12" of coverage
5/13/2010 Checked tanks & lines

INITIAL SITE SKETCH

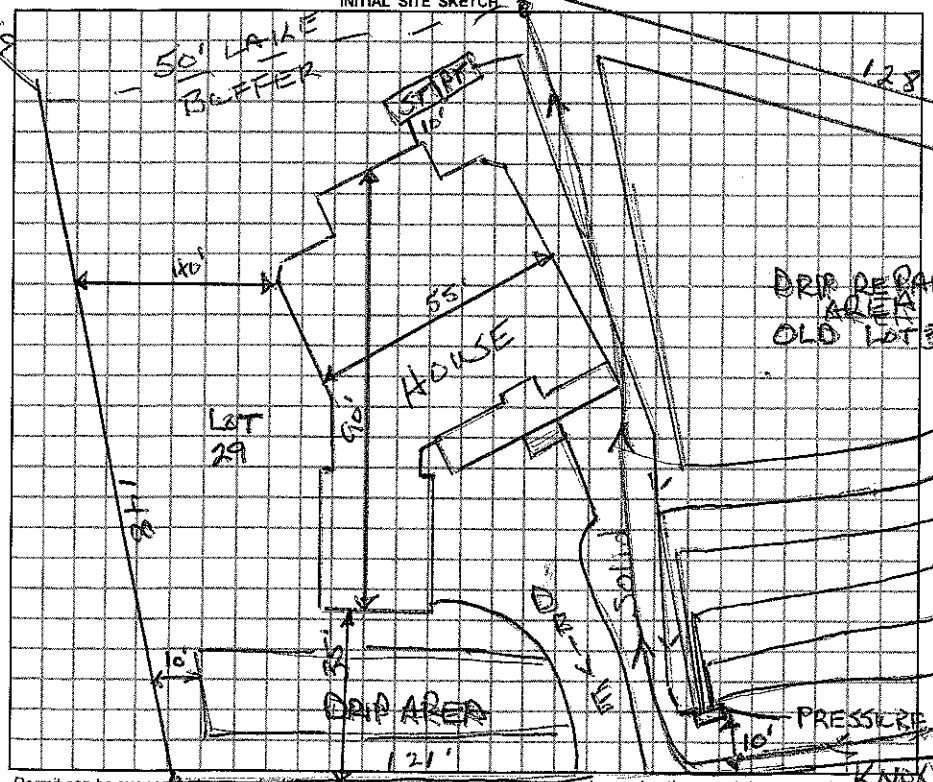

AS BUILT SKETCH

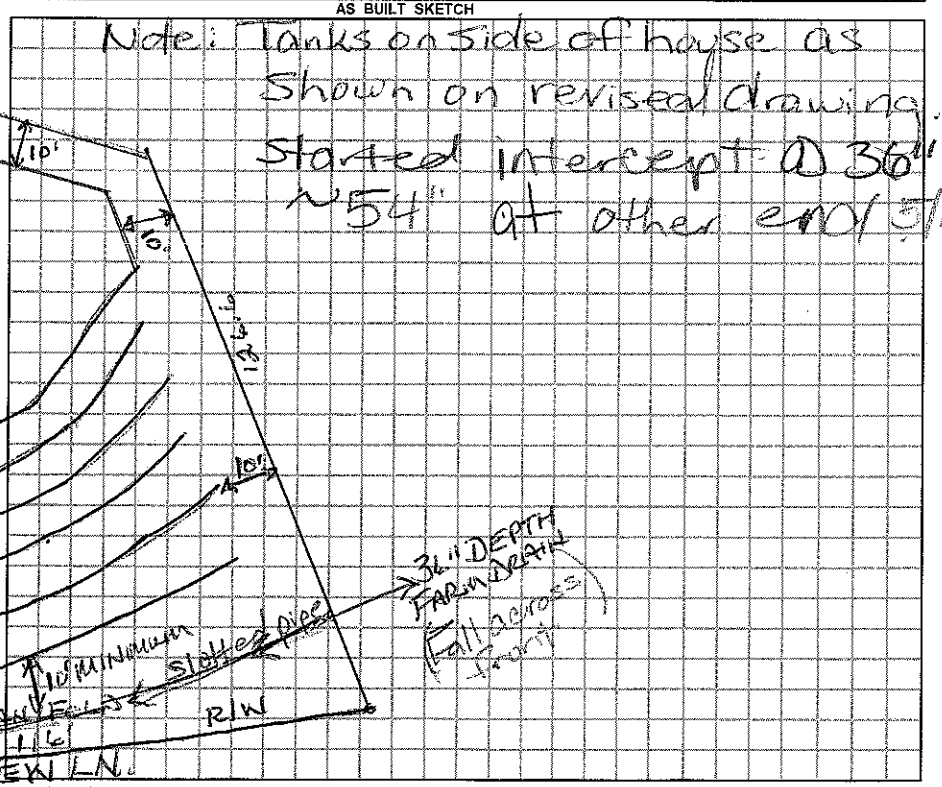

Permit can be suspended or revoked if any false information is supplied toward securing the permit / any unauthorized changes are made to the site / any unauthorized changes are made in the installation of the system.

☐ *IMPROVEMENT PERMIT w / plat valid without expiration.* ☐ *IMPROVEMENT PERMIT w / site plan valid for 60 mos.* ☒ *AUTHORIZATION TO CONSTRUCT valid for period equal to IMPROVEMENT PERMIT-not to exceed 60 mo.*

Owner / Applicant Signature: X [signature] Date 9/28/09

Improvement Permit by: Wesley Sparks R.S. Date 9/28/09

Authorzation to Construct by: Wesley Sparks R.S. Date 9/28/09

YOU SHOULD CONTACT A LOCATOR SERVICE PRIOR TO ANY EXCAVATION.

Installed by: R&H RS

Operation Permit by: [signature] Date: 6/25/2010

Existing System Inspected by: Date:

WHITE COPY Environmental Health YELLOW COPY (Final) Owner / Applicant PINK COPY (Initial) Owner / Applicant

IREDELL COUNTY HEALTH DEPARTMENT

STATESVILLE 704-878-5305 (D) MOORESVILLE 704-664-5281

IMPROVEMENT PERMIT / AUTHORIZATION TO CONSTRUCT / OPERATION PERMIT / EXISTING SYSTEM INSPECTION

PERMIT# 128454 PIN# 4634 99 4954 DATE 5/13/05

OWNER OR CONTRACTOR Wilson [redacted] Prop. LTD PTR PHONE: Business 704-872-2411 Home

ADDRESS 190 Wilson Park Rd Statesville NC 28625

LOCATION 1155, TR, Langtree, TL 2nd Knoxview, on Rt

SUBDIVISION Kings Landing BLOCK / SECTION LOT 29 LOT AREA 0.937 AC SITE CLASS. PS DESIGN FLOW 480 L.T.A.R. 0.25

Septic Tank: 1000 Gallons: STB Date

Pump Tank: 1000 Gallons: PT Date

Pump Make: Model Serial No.

Nitrification Field: No Fields 1 Square Feet 1440 Linear Feet 480

No Lines 3@160' Trench Width 36" Max Trench Bottom Depth 24" Gravel Depth —

☒ New System ☐ Repair System Type: I, II, III, IV, V, VI

System Description: PM 25% Reduction (Shallow)

Repair System Description: Same (LP)

Maintenance Agreement Required: ☐ Yes ☒ No

☒ House/Mod. Home ☐ Mobile Home ☐ Business ☐ Other

No. Bedrooms 4 No. Bathrooms No. Employees

☐ Slab ☐ Crawl Space ☒ Basement w/plumbing ☐ Basement wo/plumbing


Water Supply: ☐ Individual ☐ Public ☒ Community

Comments:/Conditions: Lot 29 combined with portion of Lot 30


1" = 50'

Comments:/Conditions:

INITIAL SITE SKETCH

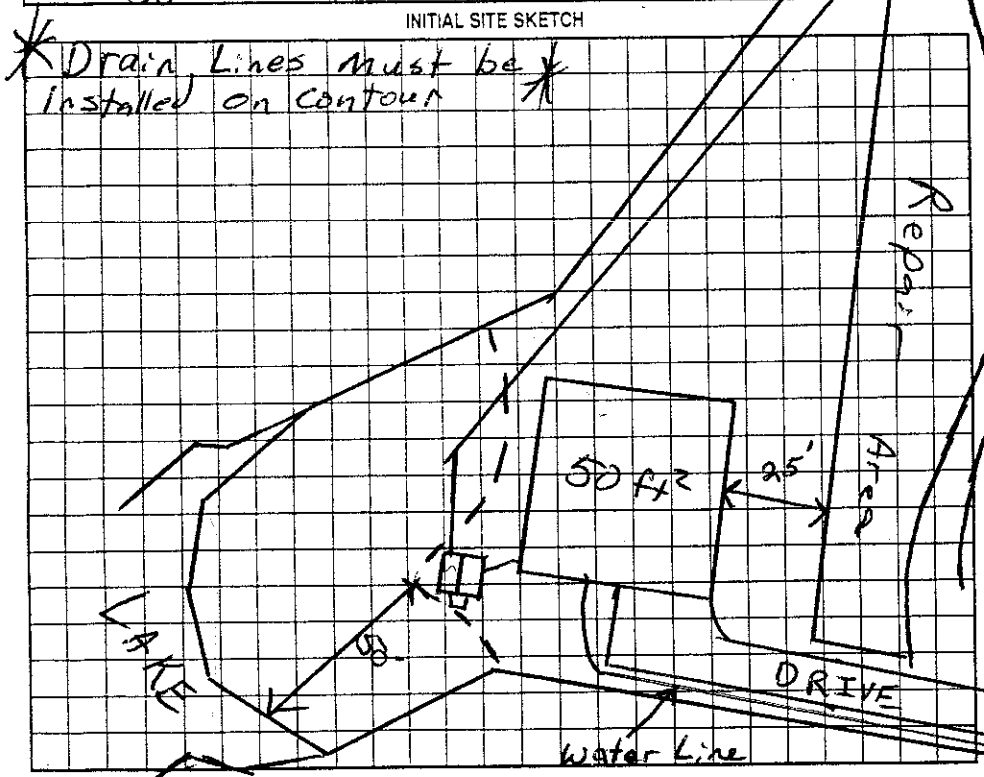

AS BUILT SKETCH

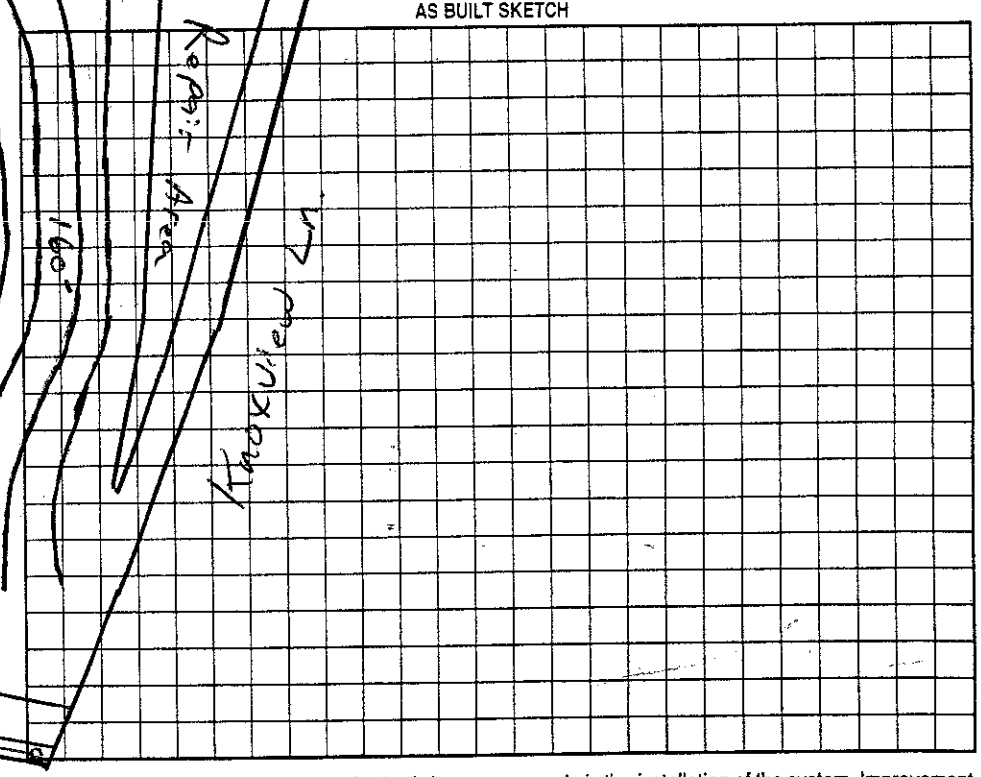

Permit can be suspended or revoked if any false information is supplied toward securing the permit/any unauthorized changes are made to the site/any unauthorized changes are made in the installation of the system. Improvement Permit with plat valid without expiration. Improvement Permit with site plan valid for sixty months. Authorization to Construct is valid for a period equal to that of Improvement Permit – not to exceed sixty months.

Signed: Elizabeth W Norton date 5-16-05 Installed by:

Improvement Permit by: RS date 5/13/05 Operation Permit by: date

Authorization to Construct by: date Existing System Inspection by: date

HEALTH DEPT. COPY: WHITE OWNER COPY (FINAL): YELLOW OWNER COPY (INITIAL): PINK