IREDELL COUNTY HEALTH DEPARTMENT

STATESVILLE 704-878-5305 MOORESVILLE 704-664-5281

IMPROVEMENT PERMIT / CERTIFICATE OF COMPLETION / OPERATION PERMIT / EXISTING SYSTEM INSPECTION

PROPERTY DESCRIPTION NO. 22010 DATE 8/27/95 TAX MAP NO. 2B 5B 21 4634 99 5101 Watershed: [X] Yes [ ] No

OWNER OR CONTRACTOR C Richard Dobson Bldrs. PHONE: Business 548-0067 Home

ADDRESS 8200 University Park St 130 Char NC. 28262

LOCATION Knox View Ln. Left on T on Knox View on (R) just past Common Area

SUBDIVISION King Landing BLOCK / SECTION 1 LOT 21 LOT AREA .68 SITE CLASS PS DESIGN FLOW 480 L.T.A.R. .35

Septic Tank: 1000 Gallons; STB 794 Date 12/29/95

Pump Tank: 1000 Gallons; PT 27 Date 11/18/95

Pump Make: Model Serial No.

Nitrification Field: No Fields 1 Square Feet 1391 Linear Feet 458

No Lines 6 Trench Width 36" Max Trench Bottom Depth 36" Gravel Depth 12"

[X] New System [ ] Repair System Type: I, II, III, IV, V, VI

System Description: Pres Manifold-Conv.

Repair System Description: Same

Maintenance Agreement Required: [X] Yes [ ] No

[X] House/Mod. Home No. Bedrooms 4

[ ] Mobile Home No. Bathrooms 3

[ ] Business No. Employees

[ ] Other


[ ] Slab [X] Crawl Space [ ] Basement w/plumbing [ ] Basement wo/plumbing

Water Supply: [ ] Individual [X] Community [ ] Public


Comments: Pressure Manifold to Conventional 6 - 1/2" IDTaps on 6' cntrs inside protection

Comments: Tanks and drainfield checked - not pressured 5/15/96 AWS

INITIAL SITE SKETCH

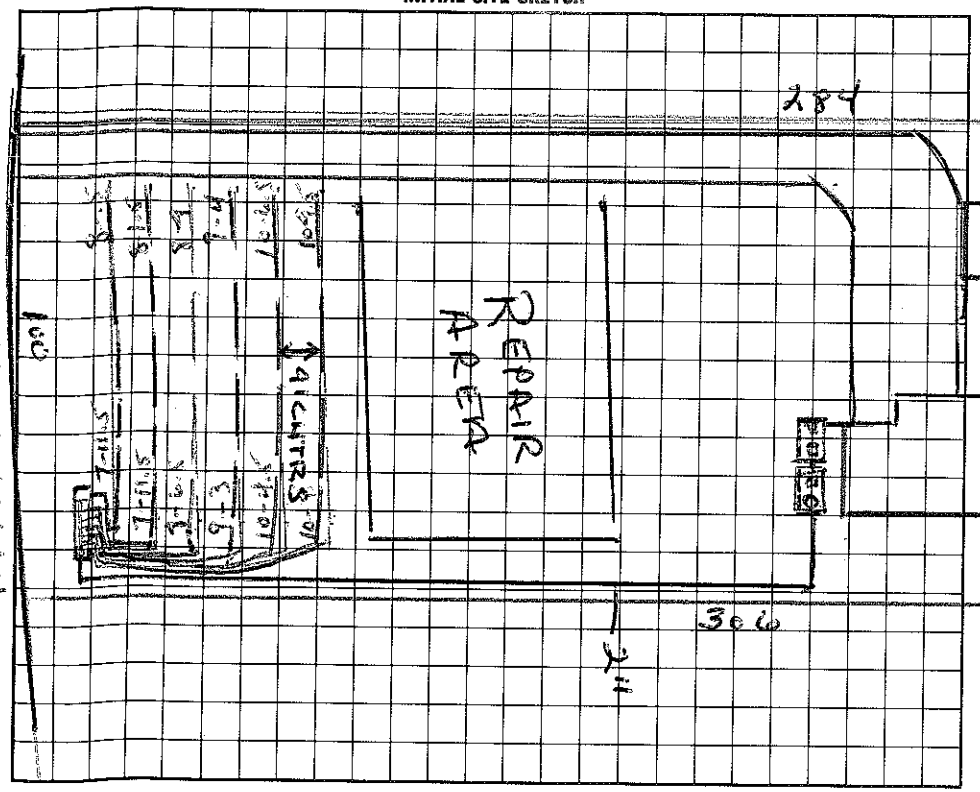

AS BUILT SKETCH

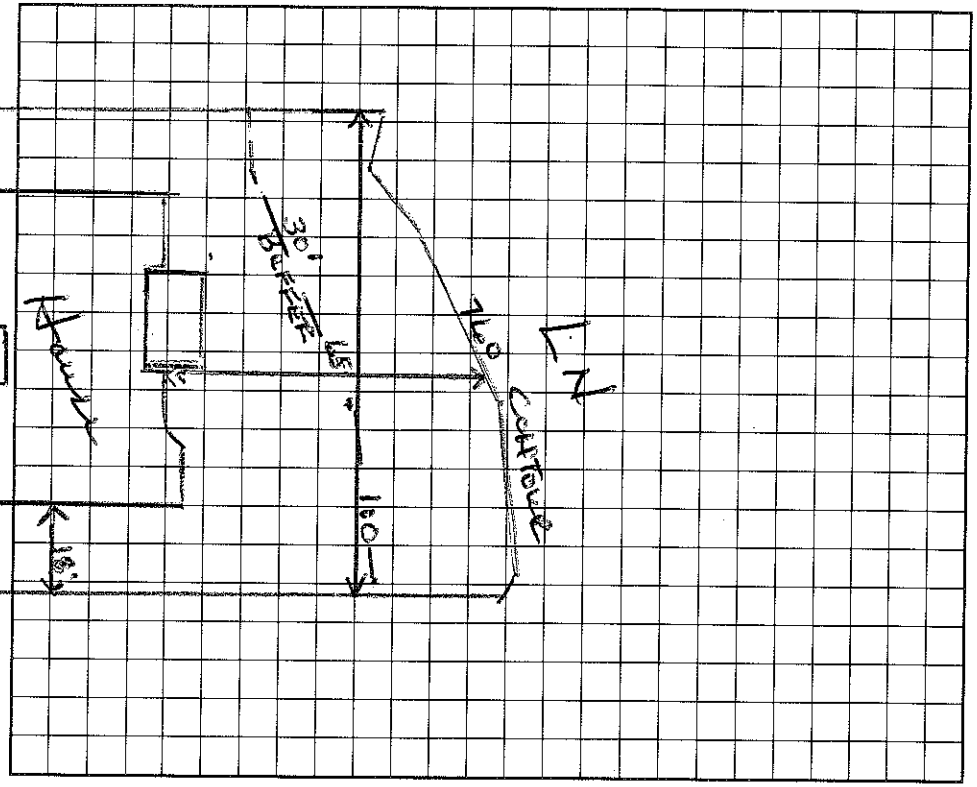

I understand that this permit can be suspended or revoked if any false information is supplied toward securing the permit/any unauthorized changes are made to the site/any unauthorized changes are made in the installation of the system.

Signed: X

Improvement Permit by: Wesley Sparks RS. date 8/27/95

Existing System Inspection by: date

Installed by: Bob Mayhew

Certificate of Completion by: date

Operation Permit by: Wesley Sparks RS. date 5/20/96

HEALTH DEPT. COPY: WHITE INSPECTION COPY (FINAL): GREEN OWNER COPY (FINAL): YELLOW INSPECTION COPY (INITIAL): PINK OWNER COPY (INITIAL): GOLD

