IREDELL COUNTY HEALTH DEPARTMENT

STATESVILLE 704-878-5305 MOORESVILLE 704-664-5281

IMPROVEMENT PERMIT / AUTHORIZATION TO CONSTRUCT / OPERATION PERMIT / EXISTING SYSTEM INSPECTION

PERMIT# 100845 PIN# 4634 99 5221

OWNER OR CONTRACTOR Howard O Burnett DATE 6/14/01

ADDRESS 1124 Tuxedo Ct. Charlotte, NC. 28211 PHONE: Business 704-367-1437 Home

LOCATION 1155 TR Langtree Rd. TL 2ND Knoxview to 11th lot on (R) 265 Knoxview Ln

SUBDIVISION Kings Landing BLOCK SECTION LOT 22 LOT AREA .66Ac SITE CLASS RS DESIGN FLOW 480 L.T.A.R. .3

Septic Tank: 1000 Gallons; STB 160 Date 11/15/01

Pump Tank: 1000 Gallons; PT 319 Date 12/27/01

Pump Make: Little Giant Model 5-MSQ-14EN Serial No. 514220

Nitrification Field: No Fields 1 Square Feet 1200 Linear Feet 400

No Lines 5@80' Trench Width 3' Max Trench Bottom Depth 3'

[X] New System [ ] Repair System Type: I, II, III, IV, V, VI

System Description: PM to Chamber Plastic

Repair System Description: Same

Maintenance Agreement Required: [ ] Yes [X] No

Gravel Depth SAND. [ ] Slab [X] Crawl Space [ ] Basement w/plumbing [ ] Basement wo/plumbing

[X] House/Mod. Home No. Bedrooms 4

[ ] Mobile Home No. Bathrooms 4

[ ] Business No. Employees


[ ] Other

Water Supply: [ ] Individual [ ] Public [X] Community


Comments:/Conditions:

Comments:/Conditions:

INITIAL SITE SKETCH (1" = 50')

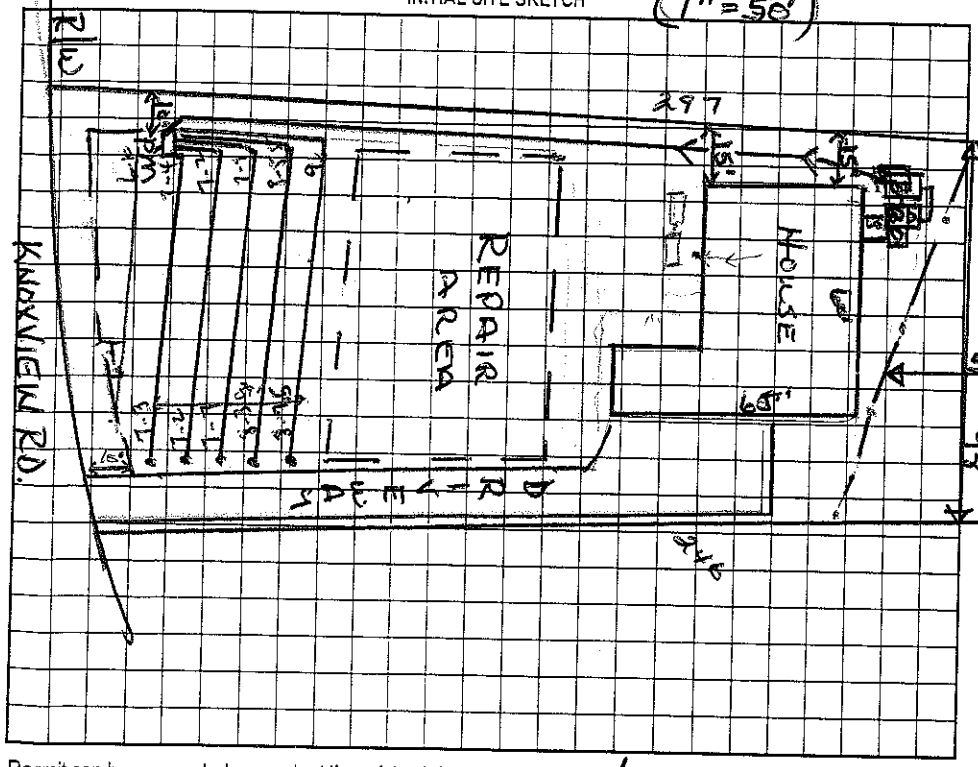

AS BUILT SKETCH

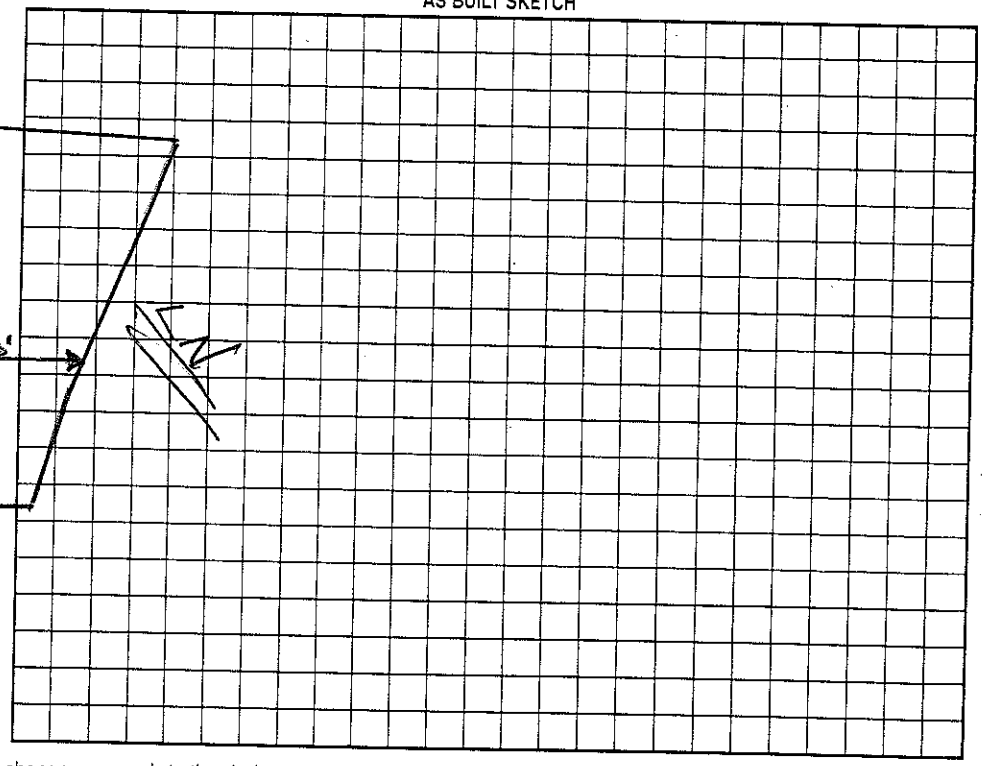

Permit can be suspended or revoked if any false information is supplied toward securing the permit/any unauthorized changes are made to the site/any unauthorized changes are made in the installation of the system. Improvement Permit with plat valid without expiration. Improvement Permit with site plan valid for sixty months. Authorization to Construct is valid for a period equal to that of Improvement Permit – not to exceed sixty months.

Signed: Howard O. Burnett date 6/15/01

Improvement Permit by: Wesley Sparks RS. date 6/14/01

Authorization to Construct by: Wesley Sparks RS. date 6/14/01

Installed by: M Sigmon Const.

Operation Permit by: Wesley Sparks RS. date 3/20/02

Existing System Inspection by: date

HEALTH DEPT. COPY: WHITE OWNER COPY (FINAL): YELLOW OWNER COPY (INITIAL): PINK