IREDELL COUNTY HEALTH DEPARTMENT

STATESVILLE 704-878-5305 MOORESVILLE 704-664-5281

IMPROVEMENT PERMIT / CERTIFICATE OF COMPLETION / OPERATION PERMIT / EXISTING SYSTEM INSPECT

PROPERTY DESCRIPTION NO. 20401 DATE March 7, 95 TAX MAP NO. 2B5A56 Watershed: ☑ Yes ☐ No WSIV

OWNER OR CONTRACTOR Dobson Builders PHONE: Business Home 4634-99-7191

ADDRESS 8220 N Ex Pwy suite 130 Charlotte

LOCATION Jamestown Road Ft-Kingsdrew Lane on left

SUBDIVISION Kings Landing BLOCK / SECTION LOT 56 LOT AREA 23580 ft² SITE CLASS Split 55 DESIGN FLOW 480gpd L.T.A.R. 0.3

Septic Tank: 1000 Gallons; STB 794 Date 6/6/95

Pump Tank: Gallons; PT Date

Pump Make: Model Serial No.

Nitrification Field: No Fields 1 Square Feet 1200 Linear Feet 400

No Lines 6 (3+3) Trench Width 36" Max Trench Bottom Depth 36" Gravel Depth N/A

☐ New System ☐ Repair System Type: I, II, III, IV, V, VI

System Description: gravity infiltrator

Repair System Description: Sand Dr pumped out

Maintenance Agreement Required: ☐ Yes ☑ No

☐ House/Mod. Home No. Bedrooms 4

☐ Mobile Home No. Bathrooms 3

☐ Business No. Employees

☐ Other

☐ Slab ☑ Crawl Space ☐ Basement w/plumbing ☐ Basement wo/plumbing


Water Supply: ☐ Individual ☑ Community ☐ Public

Comments:


Comments:

1" = 40'

INITIAL SITE SKETCH

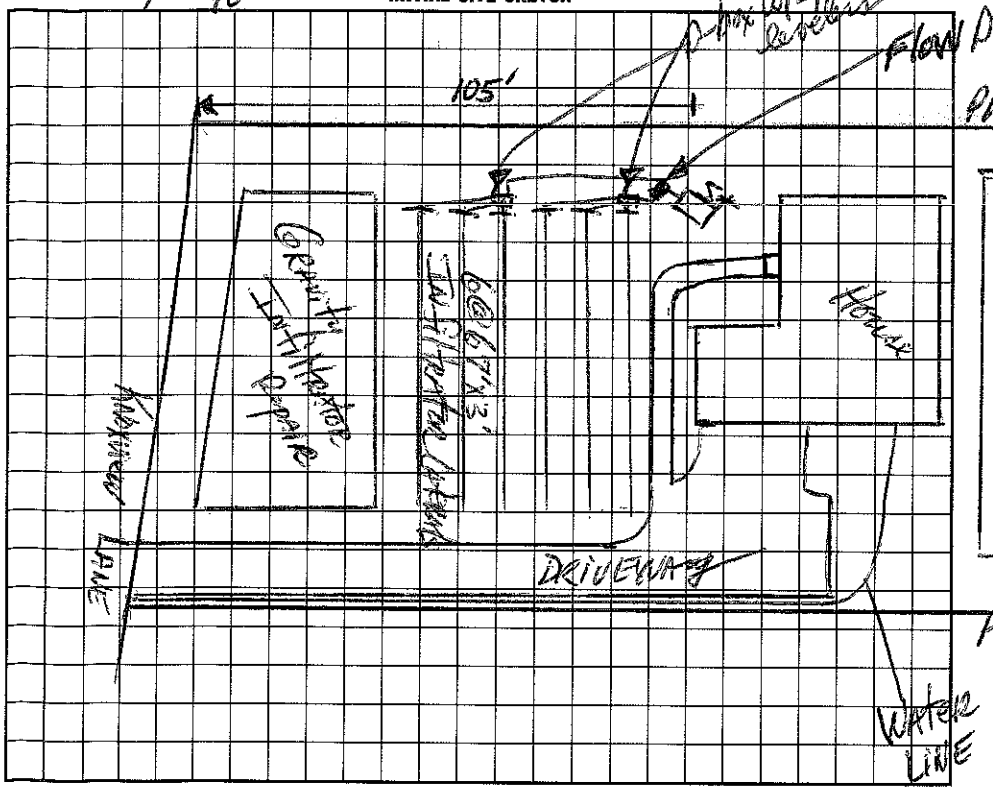

AS BUILT SKETCH

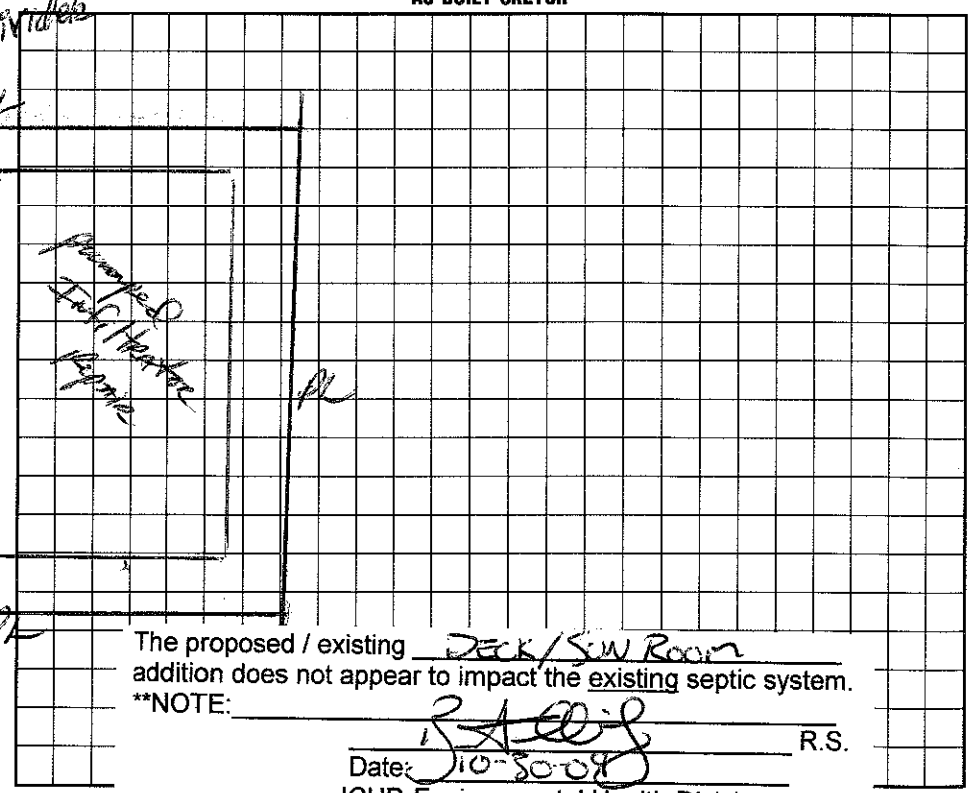

The proposed / existing Deck / Sun Room addition does not appear to impact the existing septic system.

**NOTE:

R.S.

Date: 10-30-08

ICHD-Environmental Health Division

I understand that this permit can be suspended or revoked if any false information is supplied toward securing the permit/any unauthori... ...he system.

Improvement Permit is valid for 60 months from date of issuance.

Signed:

Improvement Permit by: Mark D. Thurman, RS date 3/9/95

Existing System Inspection by: date

Installed by: Bobby Mayhew

Certificate of Completion by: Wesley Sparks RS. date 9/3/95

Operation Permit by: date

HEALTH DEPT. COPY: WHITE INSPECTION COPY (FINAL): GREEN OWNER COPY (FINAL): YELLOW INSPECTION COPY (INITIAL): PINK OWNER COPY (INITIAL): GOLD