IREDELL COUNTY HEALTH DEPARTMENT

Author to Construct

704-878-5305 MOORESVILLE 704-664-5281

IMPROVEMENT PERMIT / CERTIFICATE OF COMPLETION / OPERATION PERMIT / EXISTING SYSTEM INSPECTION

PROPERTY DESCRIPTION NO. 19899 DATE 6/11/97 TAX MAP NO. 2B B 2 Pt of F Watershed: [X] Yes [ ] No

OWNER OR CONTRACTOR Bryan Eakins PHONE: Business 896-7636 Home 4634-99-7361

ADDRESS 100 Ashford Hollow Ln. Mooresville, NC. 28115

LOCATION Knoxview Lane, Longtree Rd. TL 2nd Knoxview proceed to the 11th lot on (L)

SUBDIVISION KINGS LANDING BLOCK / SECTION 1 LOT 54 LOT AREA .55 SITE CLASS. PS DESIGN FLOW 480 L.T.A.R. .3

Septic Tank: 1000 Gallons; STB 1012 Date 12/10/97

Pump Tank: ____ Gallons; PT ____ Date ____

Pump Make: ____ Model ____ Serial No. ____

Nitrification Field: No. Fields 1 Square Feet 1599 Linear Feet 533

No. Lines 4+4(8) Trench Width 36" Max Trench Bottom Depth 36" Gravel Depth 12"

[X] New System [ ] Repair System Type: I, II, (III) IV, V, VI

System Description: FLOW DIVIDER → TWO DIST BOXES

Repair System Description: Pressure (Rear of House)

Maintenance Agreement Required: [ ] Yes [X] No

[X] House/Mod. Home No. Bedrooms 4

[ ] Mobile Home No. Bathrooms 3

[ ] Business No. Employees ____

[ ] Other ____


[ ] Slab [X] Crawl Space [ ] Basement w/plumbing [ ] Basement wo/plumbing

Water Supply: [ ] Individual [X] Community [ ] Public


Comments:

Comments:

INITIAL SITE SKETCH

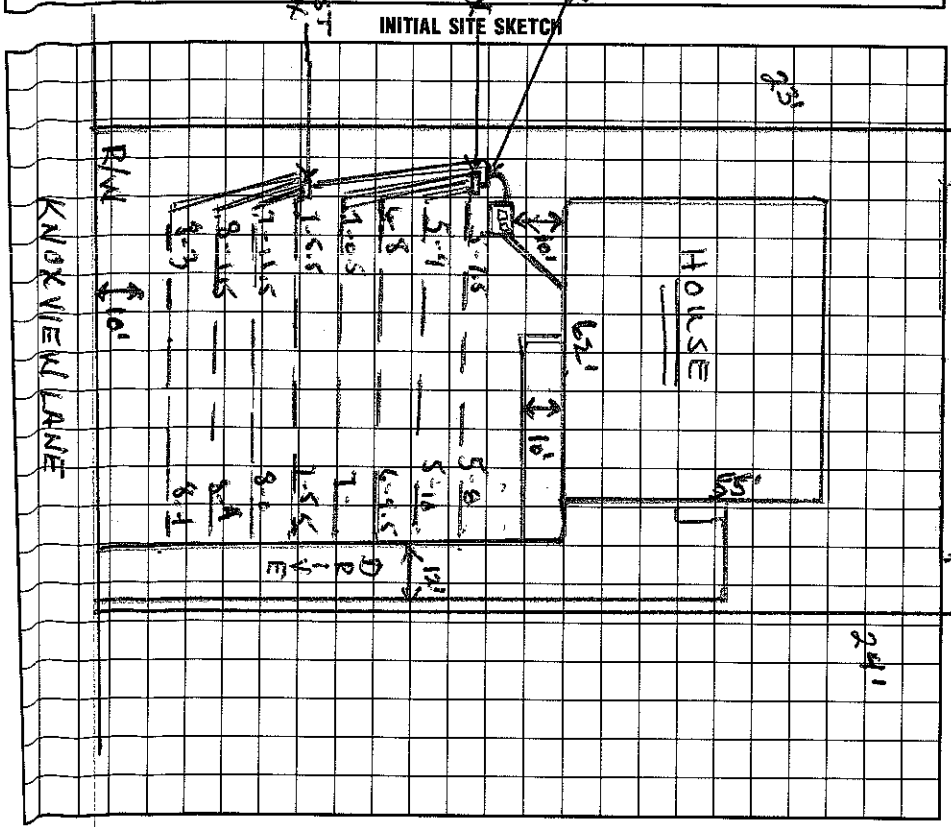

AS BUILT SKETCH

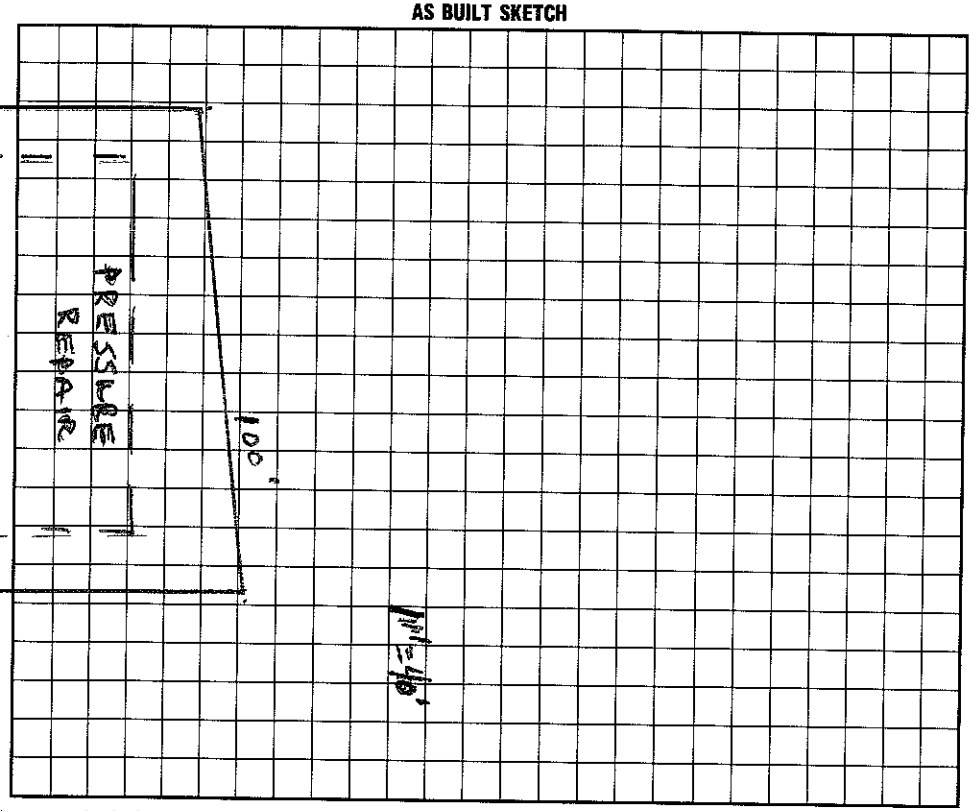

I understand that this permit can be suspended or revoked if any false information is supplied toward securing the permit/any unauthorized changes are made to the site/any unauthorized changes are made in the installation of the system. Improvement Permit is valid for 60 months from date of issuance.

Signed: [signature]

Improvement Permit by: Wesley Sparks R.S. date 6/11/97

Existing System Inspection by: Wesley Sparks R.S. date 6/11/97

Installed by: Richard Weymouth

Certificate of Completion by: Wesley Sparks R.S. date 3/23/98

Operation Permit by: Wesley Sparks R.S. date 3/23/98

HEALTH DEPT. COPY: WHITE / INSPECTION COPY (FINAL): GREEN / OWNER COPY (FINAL): YELLOW / INSPECTION COPY (INITIAL): PINK / OWNER COPY (INITIAL): GOLD