IREDELL COUNTY HEALTH DEPARTMENT

STATESVILLE 704-878-5305 MOORESVILLE 704-664-5281

IMPROVEMENT PERMIT / AUTHORIZATION TO CONSTRUCT / OPERATION PERMIT / EXISTING SYSTEM INSPECTION

PERMIT# 137445 PIN# 4634 99 7431 DATE 8/31/06

OWNER OR APPLICANT Bryan Eggkins PHONE: Business 704 996-3761 Home 704 799 0455

ADDRESS 141 Spring Run Rd Mooresville NC 28117

LOCATION 1155 TR Langtree, TL 2nd Knoxview, on Lt

SUBDIVISION Kings Landing BLOCK / SECTION ____ LOT 53 LOT AREA 0.689 AC SITE CLASS. PS DESIGN FLOW 660 L.T.A.R. 0.3

Septic Tank: 1500 Gallons; STB 944 Date 12/3/07
Pump Tank: ____ Gallons; PT ____ Date ____
Pump Make: ____ Model ____ Serial No. ____
Nitrification Field: No Fields 1 Square Feet 1500 Linear Feet 500'
No Lines 7@72 Trench Width 36" Max Trench Bottom Depth 36"

☒ New System ☐ Repair ☐ Expansion System Type: I (II) III IV V VI
System Description: 25% Reduction
Repair System Description: LP Panel Block
Maintenance Agreement Required: ☐ Yes ☒ No

☒ House/Mod. Home ☐ Mobile Home ☐ Business ☐ Other
No. Bedrooms 5 No. Persons ____ No. Employees ____

Water Supply: ☒ Individual ☐ Public ☒ Community


Gravel Depth — ☒ Gravity ☐ Pressure ☐ Slab ☒ Crawl Space ☐ Basement w/plumbing ☐ Basement wo/plumbing

Comments:/Conditions:


1"=50'

Comments:/Conditions:

INITIAL SITE SKETCH

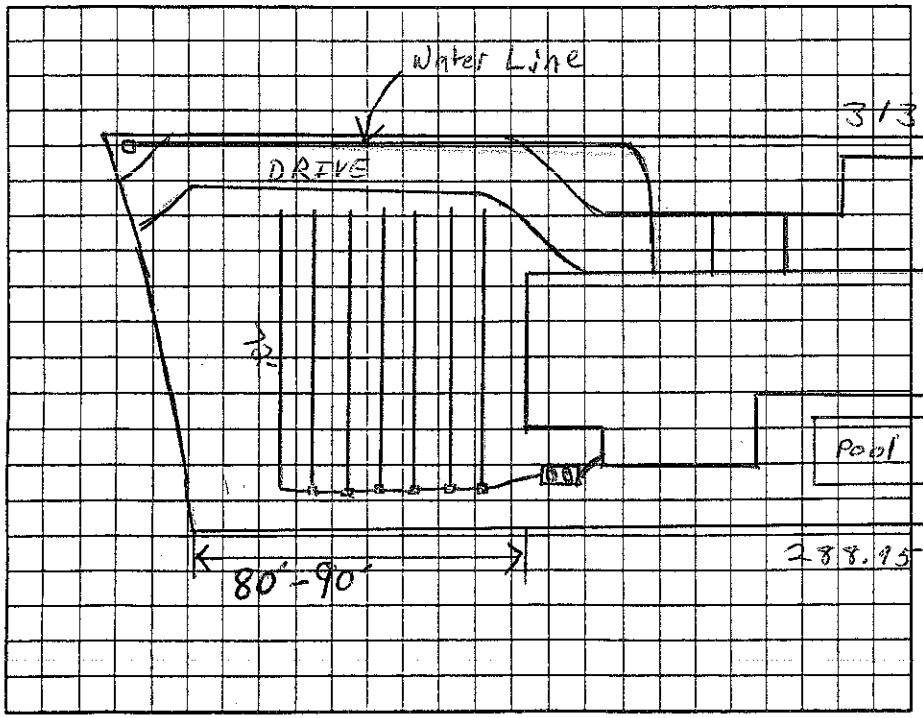

AS BUILT SKETCH

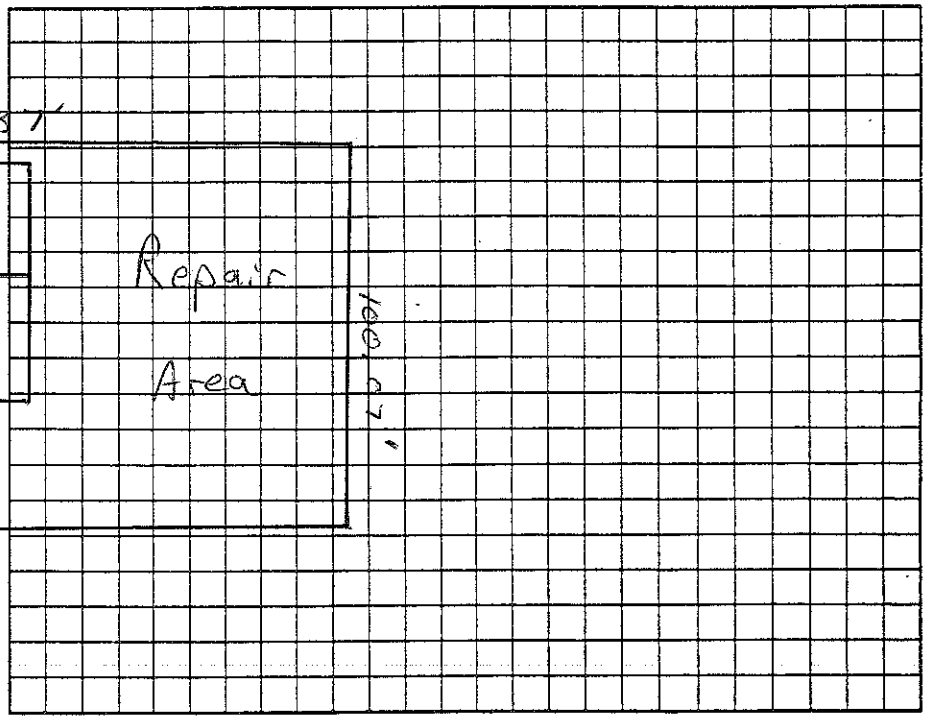

Permit can be suspended or revoked if any false information is supplied toward securing the permit/any unauthorized changes are made to the site/any unauthorized changes are made in the installation of the system. Improvement Permit with plat valid without expiration. ☐ Improvement Permit with site plan valid for sixty months ☐ Authorization to Construct is valid for a period equal to that of Improvement Permit – not to exceed sixty months.

Signed: ____ date 8/31/06

Improvement Permit by: ____ RS date 8/31/06

Authorization to Construct by: ____ RS date 8/31/06

Installed by: ____

Operation Permit by: Wesley Sparks RS date 5/6/08

Existing System Inspection by: ____ date ____

HEALTH DEPT. COPY: WHITE OWNER COPY (FINAL): YELLOW OWNER COPY (INITIAL): PINK