IREDELL COUNTY HEALTH DEPARTMENT

STATESVILLE 704-878-5305 MOORESVILLE 704-664-5281

IMPROVEMENT PERMIT / CERTIFICATE OF COMPLETION / OPERATION PERMIT / EXISTING SYSTEM INSPECTION

PROPERTY DESCRIPTION NO. 20290 DATE Feb 28 95 TAX MAP NO. 2B5B57 Watershed: ☑ Yes ☐ No WS IV

OWNER OR CONTRACTOR Dobson Builders PHONE: Business 4634-99-7610 Home

ADDRESS 8220 Ey Park # 130 Charlotte 28262

LOCATION 1155 TR 1102 TL Knoxview on left

SUBDIVISION Kings Landing BLOCK / SECTION LOT 51 LOT AREA 30,000 ft² SITE CLASS. 15 DESIGN FLOW 450 gpd L.T.A.R. .3

Septic Tank: 1000 Gallons; STB 794 Date 2-22-95

Pump Tank: Gallons; PT Date

Pump Make: Model Serial No.

Nitrification Field: No Fields 1 Square Feet 1600 Linear Feet 534

No Lines 4+4 Trench Width 36" Max Trench Bottom Depth 30" Gravel Depth 12"

☑ New System ☐ Repair System Type: I, II, III, IV, V, VI

System Description: gravity conventional

Repair System Description: pumped conventional

Maintenance Agreement Required: ☑ Yes ☑ No

☑ House/Mod. Home No. Bedrooms 4

☐ Mobile Home No. Bathrooms 3

☐ Business No. Employees

☐ Other

☐ Slab ☑ Crawl Space ☐ Basement w/plumbing ☐ Basement wo/plumbing


Water Supply: ☐ Individual ☑ Community ☐ Public

Comments: Laterals to follow contour, Exit plumbing at existing grade.

Comments: 5/12/95 Checked drainfield - upper D/Box leaking needs to be repaired Ans

1"=50'

INITIAL SITE SKETCH

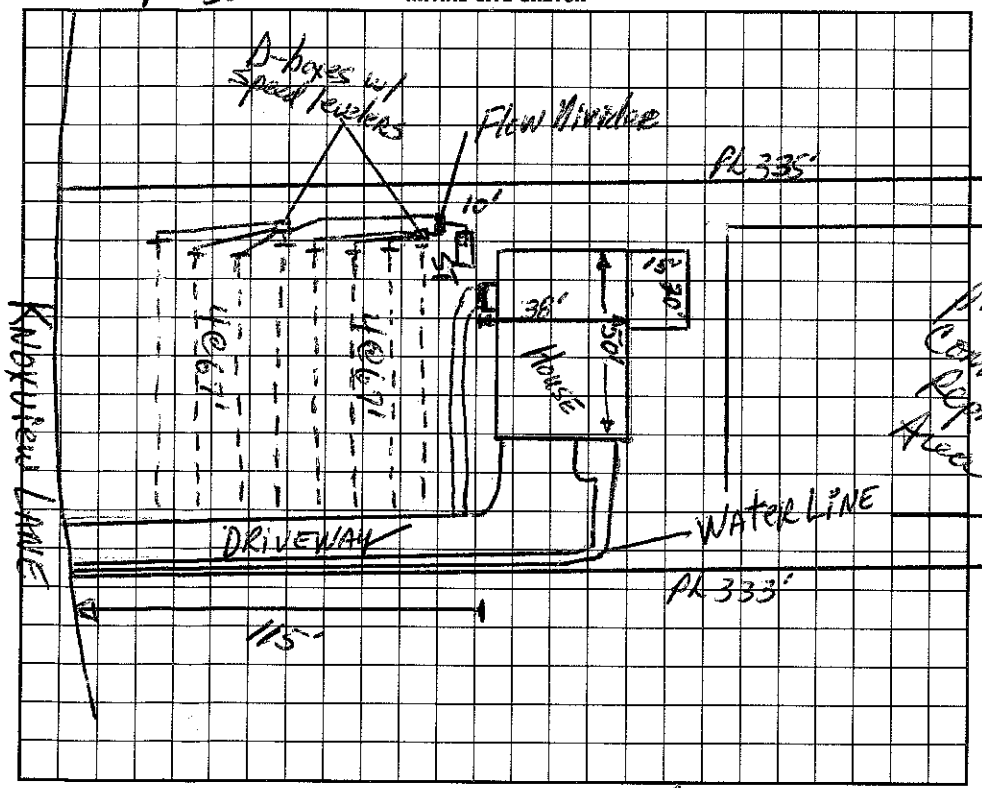

AS BUILT SKETCH

I understand that this permit can be suspended or revoked if any false information is supplied toward securing the permit/any unauthorized changes are made to the site/any unauthorized changes are made in the installation of the system. Improvement Permit is valid for 60 months from date of issuance.

Signed:

Improvement Permit by: date 2/28/95

Existing System Inspection by: date

Installed by: Bob Mayhew

Certificate of Completion by: Winkler Parker RS. date 5/22/95

Operation Permit by: date

HEALTH DEPT. COPY: WHITE INSPECTION COPY (FINAL): GREEN OWNER COPY (FINAL): YELLOW INSPECTION COPY (INITIAL): PINK OWNER COPY (INITIAL): GOLD