IREDELL COUNTY HEALTH DEPARTMENT

Authorization to Construct

STATESVILLE 704-878-5305 MOORESVILLE 704-664-5281

IMPROVEMENT PERMIT / ~~CERTIFICATE OF COMPLETION~~ / OPERATION PERMIT / EXISTING SYSTEM INSPECTION

PROPERTY DESCRIPTION NO. ~~25715~~ 25715 DATE 12/6/96 TAX MAP NO. 2B-5-A-48 Watershed: [X] Yes [ ] No

OWNER OR CONTRACTOR C R Dobson Bldrs. PHONE: Business 548-0067 Home

ADDRESS 8220 Univ. Exec. Park Suite # 130

LOCATION Langtree TL 2nd Knoxview Dr. to 7th lot on (L)

SUBDIVISION Kings Landing BLOCK / SECTION 1 LOT 50 LOT AREA .75 Ac SITE CLASS PS DESIGN FLOW 480 L.T.A.R. .3

Septic Tank: 1000 Gallons; STB 794 Date 3/21/97

Pump Tank: 1000 Gallons; PT 27 Date 5/3/97

Pump Make: HYDROMATIC Model 51-A Serial No.

Nitrification Field: No Fields 1 Square Feet 1260 Linear Feet 426

No Lines 6 Trench Width 36" Max Trench Bottom Depth 36" Gravel Depth SAND.

[X] New System [ ] Repair System Type: I, II, (III), IV, V, VI

System Description: CH PLASTIC

Repair System Description: CH PLASTIC

Maintenance Agreement Required: [ ] Yes [ ] No

[X] House/Mod. Home No. Bedrooms 4

[ ] Mobile Home No. Bathrooms 3

[ ] Business No. Employees

[ ] Other

[ ] Slab [X] Crawl Space [ ] Basement w/plumbing [ ] Basement wo/plumbing


Water Supply: [ ] Individual [X] Community [ ] Public

Comments:


Comments:

420
.6
252

INITIAL SITE SKETCH

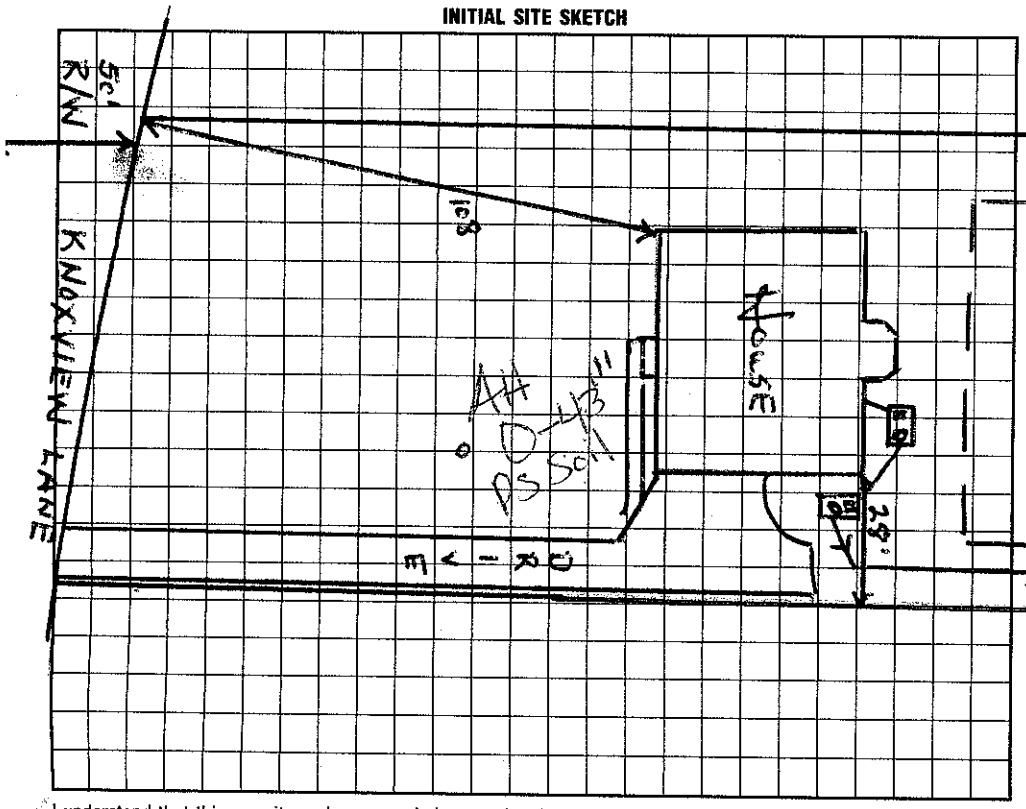

AS BUILT SKETCH

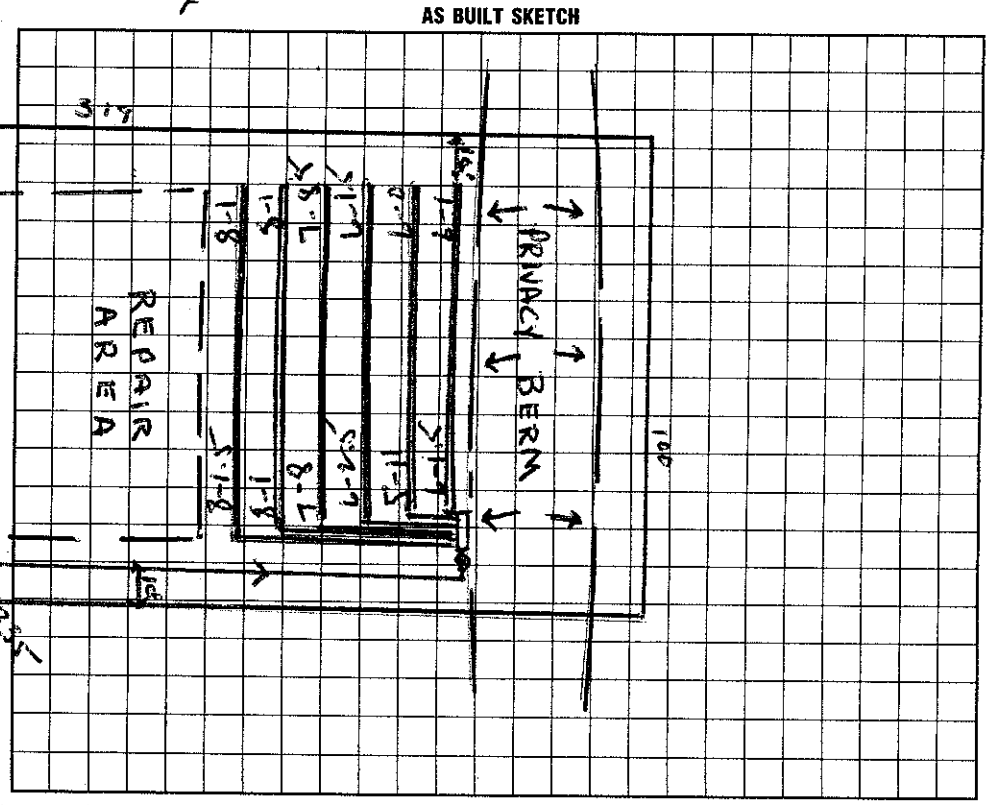

I understand that this permit can be suspended or revoked if any false information is supplied toward securing the permit/any unauthorized changes are made to the site/any unauthorized changes are made in the installation of the system.

Signed: [signature]

Improvement Permit by: Wesley Sparks RS. date 12/6/96

Existing System Inspection by: Wesley Sparks RS. date 12/6/96

Installed by: Bob Mayhew

Certificate of Completion by: date

Operation Permit by: [signature] EHSF date 7/24/97

HEALTH DEPT. COPY: WHITE INSPECTION COPY (FINAL): GREEN OWNER COPY (FINAL): YELLOW INSPECTION COPY (INITIAL): PINK OWNER COPY (INITIAL): GOLD