IREDELL COUNTY HEALTH DEPARTMENT

STATESVILLE 704-878-5305 MOORESVILLE 704-664-5281

IMPROVEMENT PERMIT / AUTHORIZATION TO CONSTRUCT / OPERATION PERMIT / EXISTING SYSTEM INSPECTION

PERMIT # 156000 PIN # 4634997831 DATE 4/28/09

OWNER or APPLICANT Anthony Comunale PHONE: Business 704.453.9340 Home:

OWNER or APPLICANT ADDRESS 746 Oswalt Mantz Rd.

LOCATION / DIRECTIONS Exit 33, L on Alcove, TR Longtree, TL 2nd → Knox View, on lft

SUBDIVISION Kings Landing BLOCK / SECTION LOT # 49 LOT AREA 30,000 ft² DESIGN FLOW 480 L.T.A.R. 0.3

Septic Tank 1000 Gallons: STB 794 Date 9/6/95

Pump Tank Gallons: P T Date

Pump Make Model Serial #

Nitrification Field No Fields 1 No Lines 8 Linear Feet 525

Trench Width Max. Trench Bottom Depth 30" Gravel Depth 12" ☒ GRAVITY ☐ PRESSURE

☐ New System ☐ Repair ☐ Expansion System Type I II III IV V VI

System Description: Existing gravity

Repair System Description: LPP PBPS

Maintenance Agreement Required ☐ YES ☒ NO

☒ Residence No. Bedrooms 4

☐ Business No. Persons

☐ Other No. Employees

☐ Slab ☒ Crawl Space


☐ Basement w/plumbing ☐ Basement w/o plumbing

Water Supply: ☐ Private ☐ Public ☒ Community


Comments / Conditions
* Pool to be no closer than 10' to the house
* Pool must stay 15' from septic tanks / repair area! Do not encroach
* Install pool as shown on permit

Comments / Conditions
* Permit only for pool / will need to have another existing system inspection when owner decides to add on to house.

INITIAL SITE SKETCH

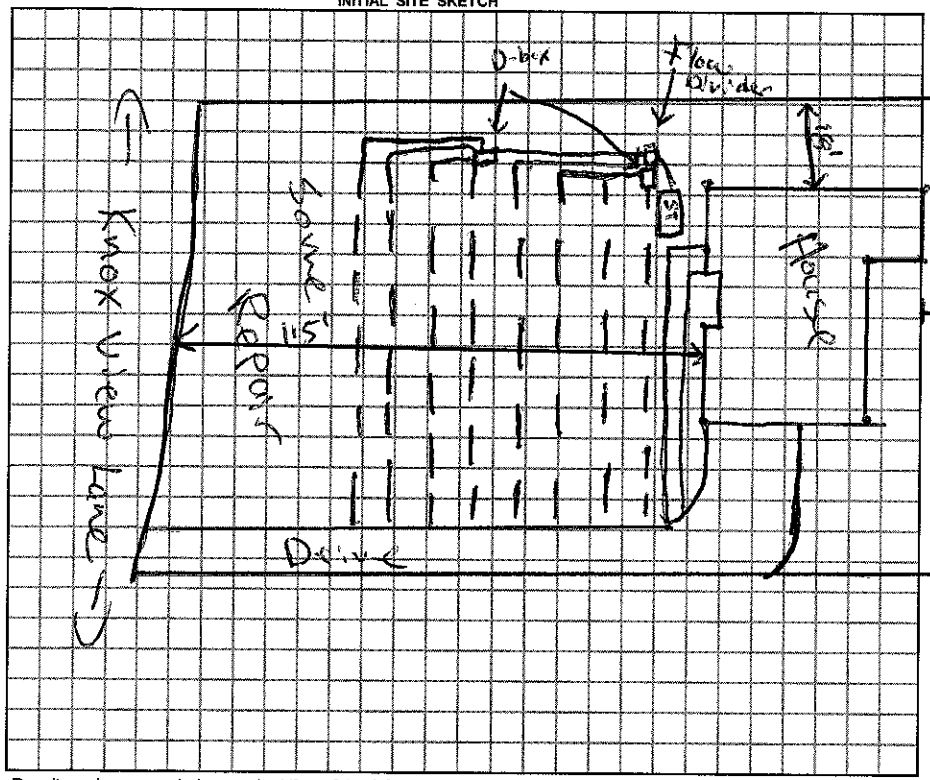

AS BUILT SKETCH

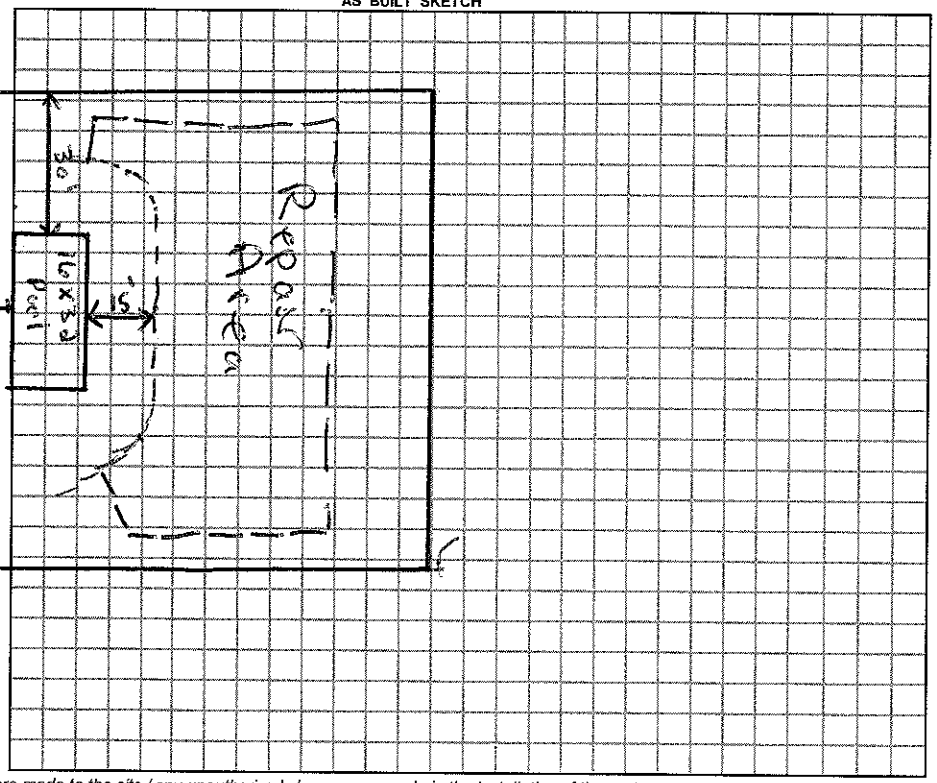

Permit can be suspended or revoked if any false information is supplied toward securing the permit / any unauthorized changes are made to the site / any unauthorized changes are made in the installation of the system.

☐ *IMPROVEMENT PERMIT w / plat valid without expiration.* ☐ *IMPROVEMENT PERMIT w / site plan valid for 60 mos.* ☐ *AUTHORIZATION TO CONSTRUCT valid for period equal to IMPROVEMENT PERMIT-not to exceed 60 mo.*

Owner / Applicant Signature: [signature] Date 5/1/09

Improvement Permit by: Date

Authorization to Construct by: Date

YOU SHOULD CONTACT A LOCATOR SERVICE PRIOR TO ANY EXCAVATION.

Installed by:

Operation Permit by: Date:

Existing System Inspected by: Randi Moore Date: 4/28/09

WHITE COPY Environmental Health YELLOW COPY (Final) Owner / Applicant PINK COPY (Initial) Owner / Applicant