IREDELL COUNTY HEALTH DEPARTMENT

STATESVILLE 704-878-5305 MOORESVILLE 704-664-5281

IMPROVEMENT PERMIT / CERTIFICATE OF COMPLETION / OPERATION PERMIT / EXISTING SYSTEM INSPECTION

PROPERTY DESCRIPTION NO. 21479 DATE 6/27/95 TAX MAP NO. 2B 5A 49 Watershed: [X] Yes [ ] No

OWNER OR CONTRACTOR C R Dobson Const. PHONE: Business 548-0867 Home

ADDRESS 8220 Univ. Exec Park Ste 130 Charlotte, NC 28262

LOCATION Knowview Ln. off Longtown

SUBDIVISION Kings Landing BLOCK / SECTION 1 LOT 49 LOT AREA 30,000 FT² SITE CLASS PS DESIGN FLOW 480 L.T.A.R. .3

Septic Tank: 1000 Gallons; STB 794 Date 9/6/95

Pump Tank: Gallons; PT Date

Pump Make: Model Serial No.

Nitrification Field: No Fields 1 Square Feet 1600 Linear Feet 525

No Lines 8 Trench Width 36" Max Trench Bottom Depth 30" Gravel Depth 12"

[X] New System [ ] Repair System Type: I [X] II, III, IV, V, VI

System Description: FLOW DIVIDER - 2 DIST BOXES

Repair System Description: PANEL PRESSURE

Maintenance Agreement Required: [ ] Yes [X] No

[X] House/Mod. Home No. Bedrooms 4

[ ] Mobile Home No. Bathrooms 3

[ ] Business No. Employees

[ ] Other


[ ] Slab [X] Crawl Space [ ] Basement w/plumbing [ ] Basement wo/plumbing

Water Supply: [ ] Individual [X] Community [ ] Public


Comments:

Comments: 8
525
49
10.5

INITIAL SITE SKETCH

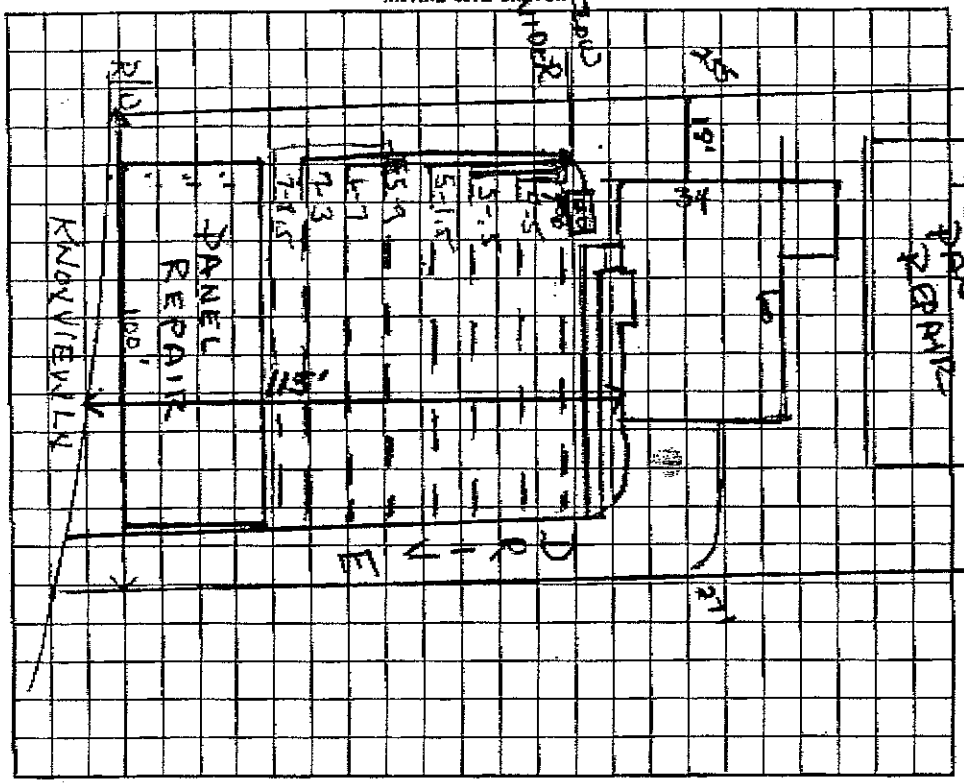

AS BUILT SKETCH

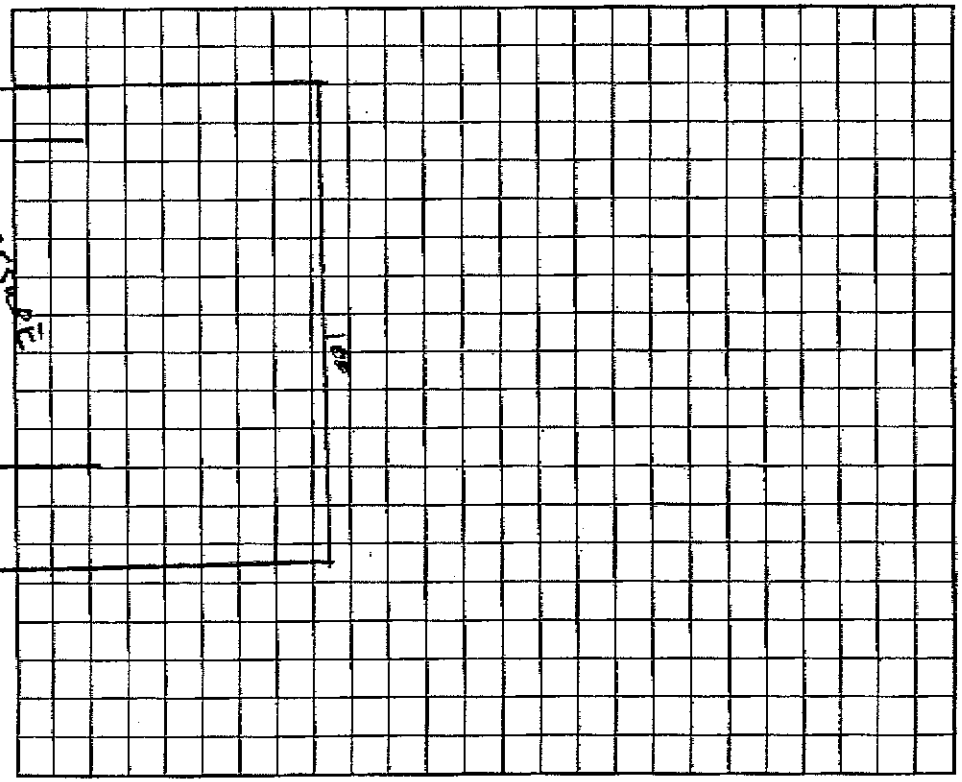

I understand that this permit can be suspended or revoked if any false information is supplied toward securing the permit/any unauthorized changes are made to the site/any unauthorized changes are made in the installation of the system. Improvement Permit is valid for 60 months from date of issuance.

Signed:

Improvement Permit by: Wesley Sparks R.S. date 6/27/95

Existing System Inspection by: date

Installed by: Bob Mayhew

Certificate of Completion by: Contract Wesley Sparks R.S. date 10/30/95

Operation Permit by: Wesley Sparks R.S. date 10/30/95

HEALTH DEPT. COPY: WHITE INSPECTION COPY (FINAL): GREEN OWNER COPY (FINAL): YELLOW INSPECTION COPY (INITIAL): PINK OWNER COPY (INITIAL): GOLD

This fax was received by the Allen Tate FaxServer