IREDELL COUNTY HEALTH DEPARTMENT

STATESVILLE 704-878-5305 MOORESVILLE 704-664-5281

IMPROVEMENT PERMIT / AUTHORIZATION TO CONSTRUCT / OPERATION PERMIT / EXISTING SYSTEM INSPECTION

PERMIT# 126583 PIN# 4634 99 7901.000 DATE 1/27/05

OWNER OR CONTRACTOR Dwight Dickerman PHONE: Business Home 704-892-6383

ADDRESS 300 Knollview Ln. Mooresville, NC. 28115

LOCATION 115 S TR Langtree Rd. TL 2ND Knollview, 4th on (L) past Castle Ct.

SUBDIVISION Kings Landing BLOCK / SECTION LOT 48 LOT AREA 1+/- .70 Ac SITE CLASS. PS DESIGN FLOW 480 L.T.A.R.

Septic Tank: EXISTING Gallons; STB Date

Pump Tank: Gallons; PT Date

Pump Make: Model Serial No.

Nitrification Field: No Fields Square Feet Linear Feet 420

No Lines Trench Width EXISTING Trench Bottom Depth Gravel Depth

☐ New System ☐ Repair System Type: I, II, (III), IV, V, VI

System Description: EX - CH PLASTIC

Repair System Description:

Maintenance Agreement Required: ☐ Yes ☒ No

☐ House/Mod. Home No. Bedrooms

☐ Mobile Home No. Bathrooms

☐ Business No. Employees

☒ Other Pool


☐ Slab ☐ Crawl Space ☐ Basement w/plumbing ☐ Basement wo/plumbing

Water Supply: ☐ Individual ☐ Public ☒ Community


Comments:/Conditions:

Comments:/Conditions:

INITIAL SITE SKETCH

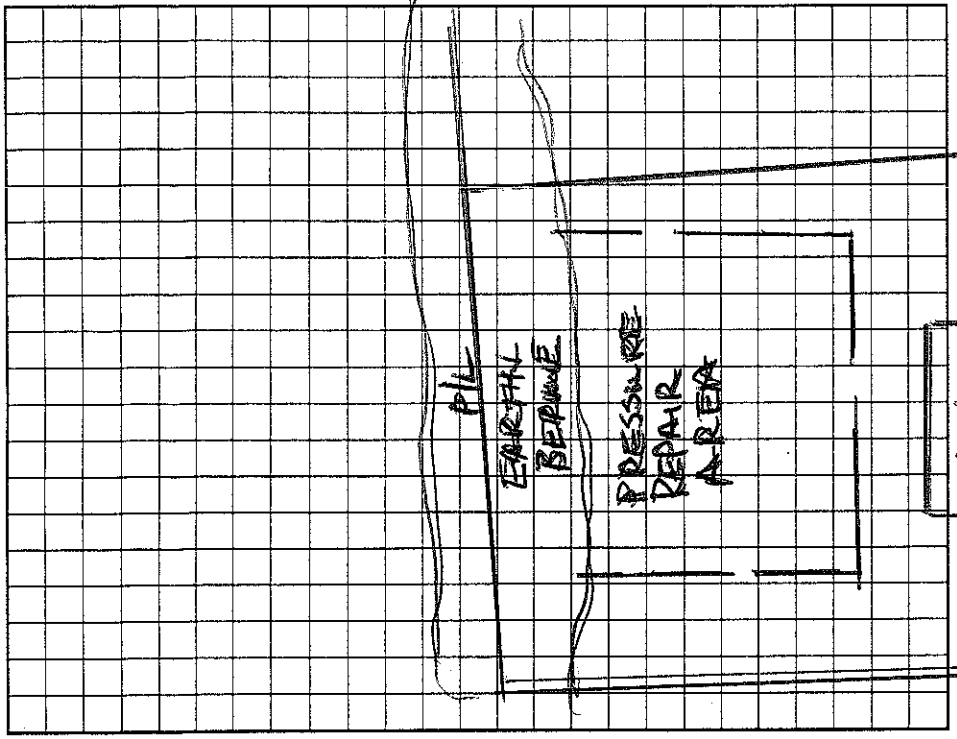

AS BUILT SKETCH

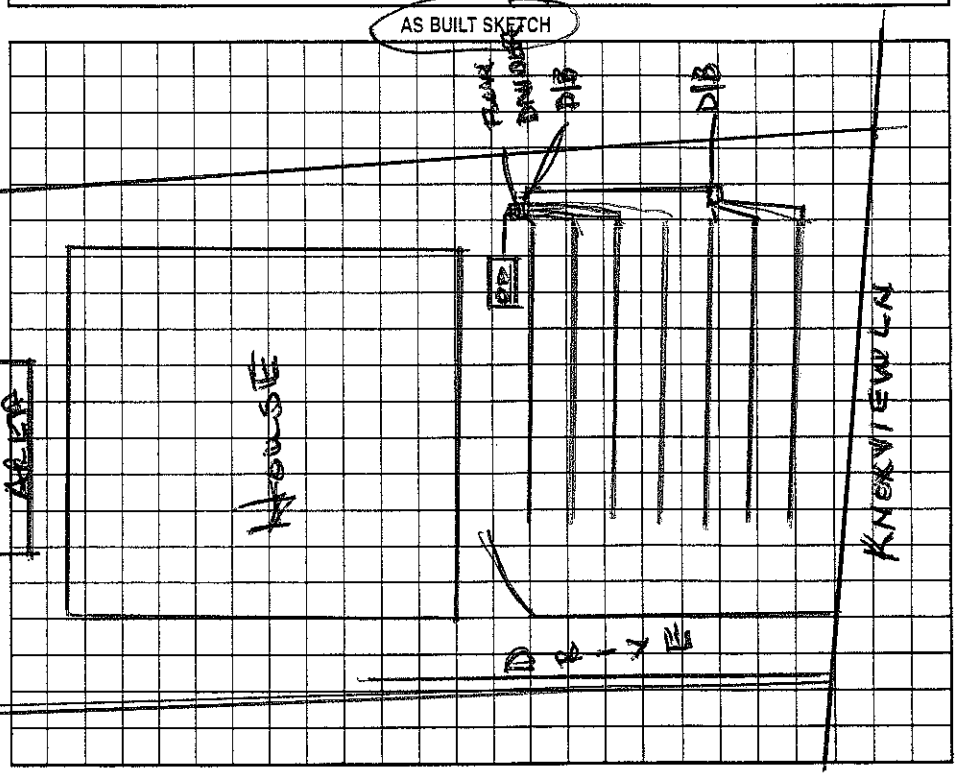

Permit can be suspended or revoked if any false information is supplied toward securing the permit/any unauthorized changes are made to the site/any unauthorized changes are made in the installation of the system. Improvement Permit with plat valid without expiration. Improvement Permit with site plan valid for sixty months. Authorization to Construct is valid for a period equal to that of Improvement Permit – not to exceed sixty months.

Signed: Harry J. McLain date 1/28/05 Installed by: FJ Erwin

Improvement Permit by: date Operation Permit by: date

Authorization to Construct by: date Existing System Inspection by: Wesley Sparkers date 1/28/05

HEALTH DEPT. COPY: WHITE OWNER COPY (FINAL): YELLOW OWNER COPY (INITIAL): PINK