100.00 Paid

IREDELL COUNTY HEALTH DEPARTMENT

STATESVILLE 704-878-5305 MOORESVILLE 704-664-5281

IMPROVEMENT PERMIT / AUTHORIZATION TO CONSTRUCT / OPERATION PERMIT / EXISTING SYSTEM INSPECTION

DATE 10/13/05

PERMIT# 118939 PIN# ~~4625 83 4957~~ 4635-01-0619

OWNER OR APPLICANT Ekrod Custom Homes PHONE: Business 704-987-5022 Home

ADDRESS PO Box 2393 Davidson, NC. 28036

LOCATION 1180 TL Yacht Rd. TL Mulford Circle on left before lot w/ Cornway Ct.

SUBDIVISION Point BLOCK / SECTION 13 LOT 1329 LOT AREA .844ac SITE CLASS. PS DESIGN FLOW 480GPD L.T.A.R. .25

Septic Tank: 1500 Gallons; STB 333 Date 10-27-06

Pump Tank: 1500 Gallons; PT 477 Date 11-7-06

Pump Make: Goulds Model WE0712HC Serial No.

Nitrification Field: No Fields 1 Square Feet 960 Linear Feet 320

No Lines 4@80' Trench Width 3' Max Trench Bottom Depth 3' Gravel Depth No

☒ New System ☐ Repair ☐ Expansion System Type: I II III (IV) V VI

System Description: 16" PPBPS - LPP

Repair System Description: Same

Maintenance Agreement Required: ☒ Yes ☐ No

☒ House/Mod. Home ☐ Mobile Home ☐ Business ☐ Other

No. Bedrooms 4 No. Persons 4 No. Employees


Water Supply: ☐ Individual ☐ Public ☒ Community POINT

☐ Gravity ☒ Pressure ☐ Slab ☐ Crawl Space ☒ Basement w/plumbing ☐ Basement wo/plumbing


Comments:/Conditions:

Comments:/Conditions:

INITIAL SITE SKETCH

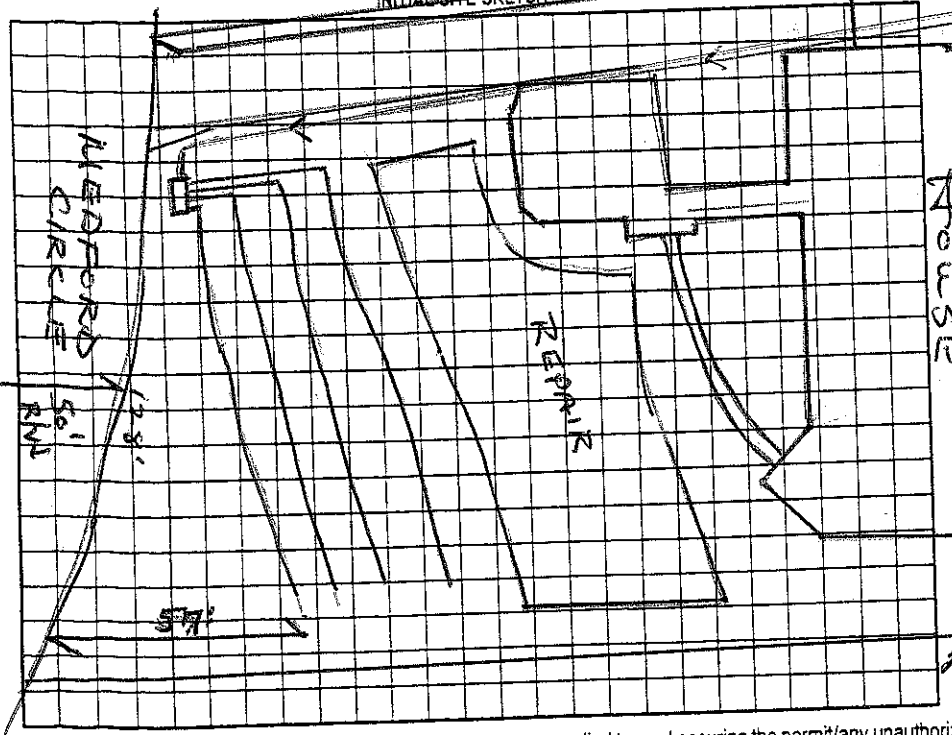

AS BUILT SKETCH

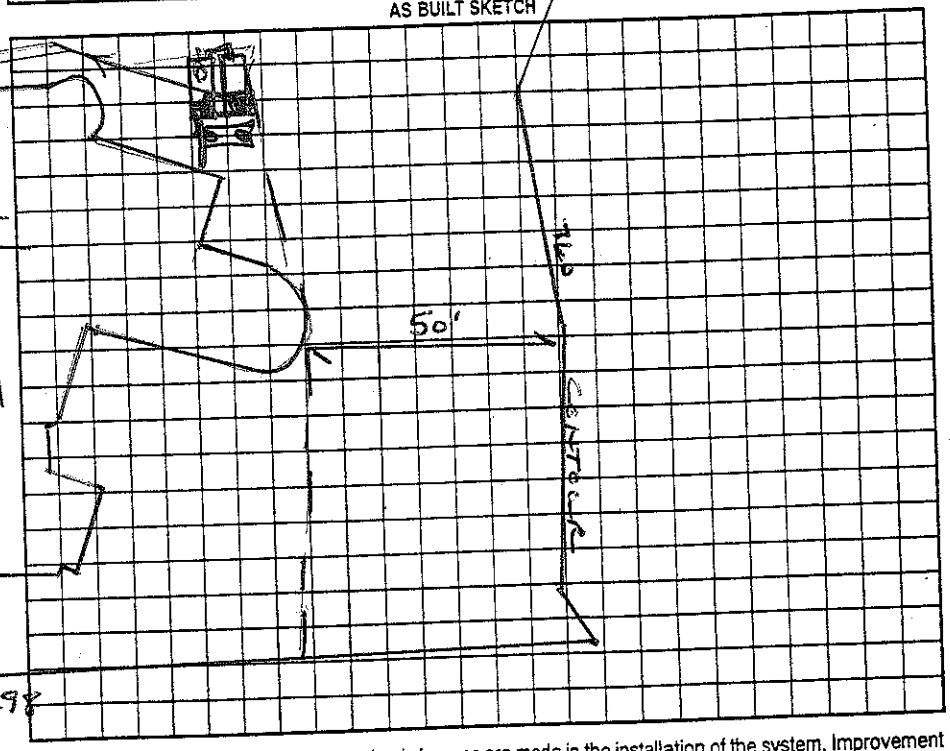

Permit can be suspended or revoked if any false information is supplied toward securing the permit/any unauthorized changes are made to the site/any unauthorized changes are made in the installation of the system. Improvement Authorization to Construct is valid for a period equal to that of Improvement Permit – not to exceed sixty months.

Permit with plat valid without expiration ☐ Improvement Permit with site plan valid for sixty months ☐

by: _____ date 10-19-05

by: Wesley Sparks RS date 10/13/05

by: Wesley Sparks RS date 10/13/05

Installed by: Orbison Wesley Sparks RS date 1/16/07

Operation Permit by: _____ date _____

Existing System Inspection by: _____ date _____

HEALTH DEPT. COPY: WHITE OWNER COPY (FINAL): YELLOW OWNER COPY (INITIAL): PINK