300

IREDELL COUNTY HEALTH DEPARTMENT

STATESVILLE 704-878-5305 MOORESVILLE 704-664-5281

IMPROVEMENT PERMIT / AUTHORIZATION TO CONSTRUCT / OPERATION PERMIT / EXISTING SYSTEM INSPECTION

PERMIT# 07759 PIN# 4625941684 4635 02 8999 DATE 4/29/99

OWNER OR CONTRACTOR Simonini Builders PHONE: Business Home

ADDRESS 817 E. Morehead, Suite 100, Charlotte, NC 28202-2705 House at 235 Falmouth Rd

LOCATION Brawley Sch. Rd. TL Pointe Dr. Queen Anne Circle to Vineyard Dr / AT/near jct. W/Falmouth Rd

SUBDIVISION The Pointe BLOCK / SECTION 1A LOT* 75, 75A LOT AREA 36,130ft² SITE CLASS. PS DESIGN FLOW 600 L.T.A.R. .3

Septic Tank: ~~750~~ 1500 Gallons; STB 338 Date 1/30/00

Pump Tank: ~~1250~~ 1000 Gallons; PT 37 Date 2/14/00

Pump Make: MYERS Model ME50S-21 Serial No.

Nitrification Field: No Fields 1 Square Feet 1500 Linear Feet 500

No Lines 5@100 Trench Width 36" Max Trench Bottom Depth 36" Gravel Depth N/A

☒ New System ☐ Repair System Type: I, II, (III), IV, V, VI

System Description: Pump/PM/Chambers/HDS.

Repair System Description: Pump/PM/Panel

Maintenance Agreement Required: ☐ Yes ☐ No

☒ House/Mod. Home ☐ Mobile Home ☐ Business ☐ Other

No. Bedrooms 5 No. Bathrooms 4 No. Employees

☐ Slab ☒ Crawl Space ☐ Basement w/plumbing ☐ Basement wo/plumbing


Water Supply: ☐ Individual ☐ Public ☐ Community

Comments:/Conditions: One inspection port per line

Comments:/Conditions:

HDS INSTALLED.

INITIAL SITE SKETCH

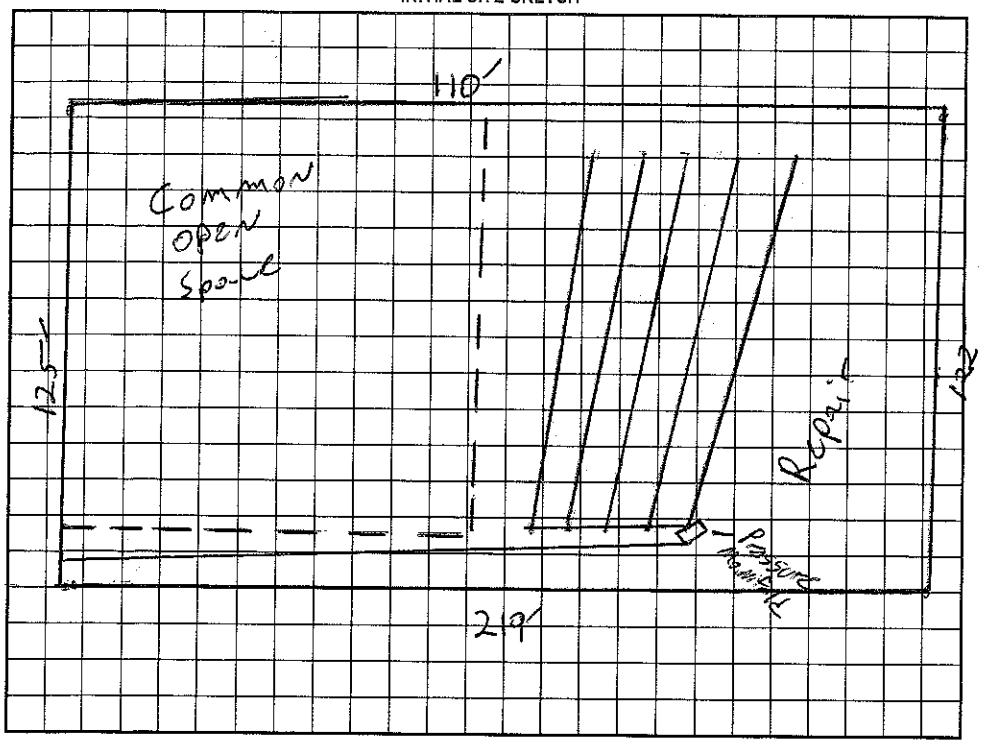

AS BUILT SKETCH

Permit can be suspended or revoked if any false information is supplied toward securing the permit/any unauthorized changes are made to the site/any unauthorized changes are made in the installation of the system. Improvement Permit with plat valid without expiration. Improvement Permit with site plan valid for sixty months. Authorization to Construct is valid for a period equal to that of Improvement Permit – not to exceed sixty months.

Signed: Tony Starkey, CSS (Agent) date 4/30/99

Improvement Permit by: Jeff Morgan date 4/29/99

Authorization to Construct by: Jeff Morgan date 4/29/99

Installed by: R+H plmg.

Operation Permit by: Maint. Tech Dixon R.S. date 4/24/00

Existing System Inspection by: date

HEALTH DEPT. COPY: WHITE OWNER COPY (FINAL): YELLOW OWNER COPY (INITIAL): PINK