IREDELL COUNTY HEALTH DEPARTMENT

STATESVILLE 704-878-5305 MOORESVILLE 704-664-5281

IMPROVEMENT PERMIT / AUTHORIZATION TO CONSTRUCT / OPERATION PERMIT / EXISTING SYSTEM INSPECTION

#50 3:30 - 4:00

PERMIT# 071760 PIN# ~~4625-94-1684~~ 4635-02-9992 DATE 9/26/02

OWNER OR CONTRACTOR William Cotter PHONE: Business (225 Falmouth Rd.) Home

ADDRESS PO Box 1003 Charlotte NC

LOCATION Brawley Sch, TL Point Dr, TL Queen Anne Cir, TL Vinyard TL Falmouth on Rt #225

SUBDIVISION Point BLOCK / SECTION 1A LOT 76 LOT AREA 35,751 Ft² SITE CLASS. PS DESIGN FLOW 480 L.T.A.R. 0.5

Septic Tank: ~~1000~~ 1500 Gallons; STB 538 Date 7/11/03

Pump Tank: 1000 Gallons; PT 27 Date 6/30/05

Pump Make: Gould's Model WE07J2HA Serial No. F0398611

Nitrification Field: No Fields / Square Feet 810 Linear Feet 270

No Lines 3@90' Trench Width 36" Max Trench Bottom Depth 30" Gravel Depth —

☒ New System ☐ Repair System Type: I, II, III, IV, V, VI

System Description: LP Panel Block

Repair System Description: same

Maintenance Agreement Required: ☒ Yes ☐ No

☒ House/Mod. Home No. Bedrooms 4

☐ Mobile Home No. Bathrooms 4

☐ Business No. Employees

☐ Other


☐ Slab ☒ Crawl Space ☐ Basement w/plumbing ☐ Basement wo/plumbing

Water Supply: ☐ Individual ☐ Public ☒ Community


Comments:/Conditions:

Comments:/Conditions:

INITIAL SITE SKETCH

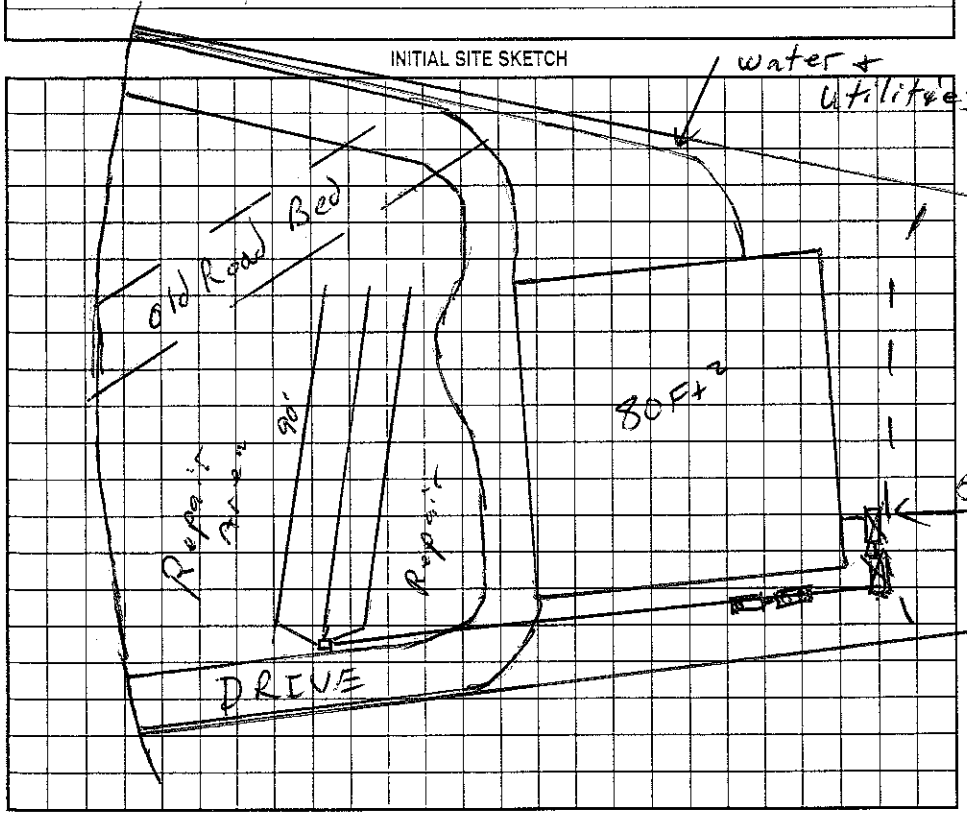

AS BUILT SKETCH

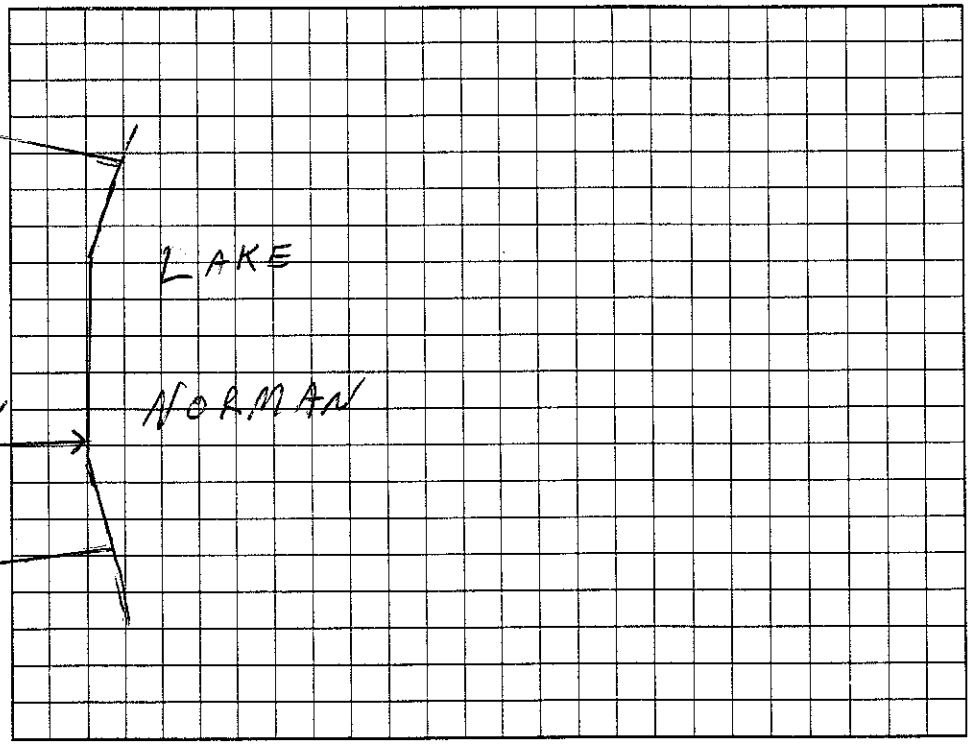

Permit can be suspended or revoked if any false information is supplied toward securing the permit/any unauthorized changes are made to the site/any unauthorized changes are made in the installation of the system. Improvement Permit with plat valid without expiration. Improvement Permit with site plan valid for sixty months. Authorization to Construct is valid for a period equal to that of Improvement Permit – not to exceed sixty months.

Signed: [signature] date 1/7/03 Installed by: Hallman Const.

Improvement Permit by: [signature] RS date 10/08/02 Operation Permit by: Wesley Sparks RS. date 10/14/03

Authorization to Construct by: [signature] RS date 10/08/02 Existing System Inspection by: date

HEALTH DEPT. COPY: WHITE OWNER COPY (FINAL): YELLOW OWNER COPY (INITIAL): PINK