Pool # 207305 ✓

IREDELL COUNTY HEALTH DEPARTMENT

Statesville Office (704) 878-5305 Mooresville Office (704) 660-3625 PERMIT # 179080 (House)

IMPROVEMENT PERMIT / AUTHORIZATION TO CONSTRUCT / OPERATION PERMIT / EXISTING SYSTEM

✓ PIN # 4635-03-4538

APPLICANT: Stonebridge Luxury Homes APPLICANT ADDRESS: Po Box 4297 Mville 28117

✓ SITE ADDRESS: 133 Vineyard Dr - Mville. PHONE: 704-400-1255 ALT. PHONE:

SITE DIRECTIONS: BSR, The Point Dr, TL Vineyard

✓ SUBDIVISION: The Point on Norman SECTION: 1A LOT # 69 LOT AREA: 1.112 AC DESIGN FLOW: 480 L.T.A.R.: .275

Septic Tank 1500 (gal) STB 4409 Date 1-19-16 ☒ New System ☐ Repair ☐ Expansion System Type: I II III ☒ IV V VI

Pump Tank 1000 (gal) PT 4717 Date 1-11-16 System Description: LP - Panel Block

Pump Make Orenco Model PF500511 Serial # 285-5005 Repair System Description: Same

Nitrification Fields 1 # Lines 5 Linear Ft: 291' Maintenance Agreement Required: ☒ YES ☐ NO

Trench Width 24" Max. Trench Bottom Depth 36" Gravel Depth ☐ GRAVITY ☒ PRESSURE

☒ Residence ☐ Business ☐ Other ☐ Slab ☐ Basement w/plumbing ☒ Crawl Space ☐ Basement w/o plumbing

No. Bedrooms 4 No. Persons ___ No. Employees ___

Water Supply: ☐ Private ☐ Public ☒ Community

Comments / Conditions:

3/1/16 Checked tanks. Tanks moved to side of house, meets all setbacks
3/7/16 Checked lines, installed - MD
Essentially as drawn.

INITIAL SITE SKETCH

SEE ATTACHED DRAWING

RA

APPROVED MAY 13 2014

AS BUILT SKETCH

5/19/16 Set pressure, Checked leak & alarm

Location of the proposed Inground pool addition does not appear to impact the existing on-site septic system or well. **NOTE: Must keep pool cut at least 15ft from Septic

Maria Dotson REHS Date: 12/16/14

ICHD-Environmental Health Division

207305

Permit can be suspended or revoked if any false information is supplied toward securing the permit / any unauthorized changes are made to the site / any unauthorized changes are made in the installation of the system. **CONTACT A LOCATOR SERVICE PRIOR TO ANY EXCAVATION**


☐ **IMPROVEMENT PERMIT** *with plat valid without expiration.* ☐ **IMPROVEMENT PERMIT** *with site plan valid for 60 mos.* ☐ **AUTHORIZATION TO CONSTRUCT** *valid for period equal to IMPROVEMENT PERMIT--not to exceed 60 mo.*

Owner / Applicant Signature: [signature] Date: 5-22-14 Installed by: Steve Jordan

IMPROVEMENT PERMIT by: RA Date: APPROVED MAY 13 2014 OPERATION PERMIT by: Maria Dotson RS Date: 5/19/16

AUTHORIZATION TO CONSTRUCT by: RA APPROVED MAY 13 2014 Existing System Inspected by: Date:

Health Dept. Copy - WHITE Applicant (Final Approval) - YELLOW Applicant (Conditional Approval) - PINK

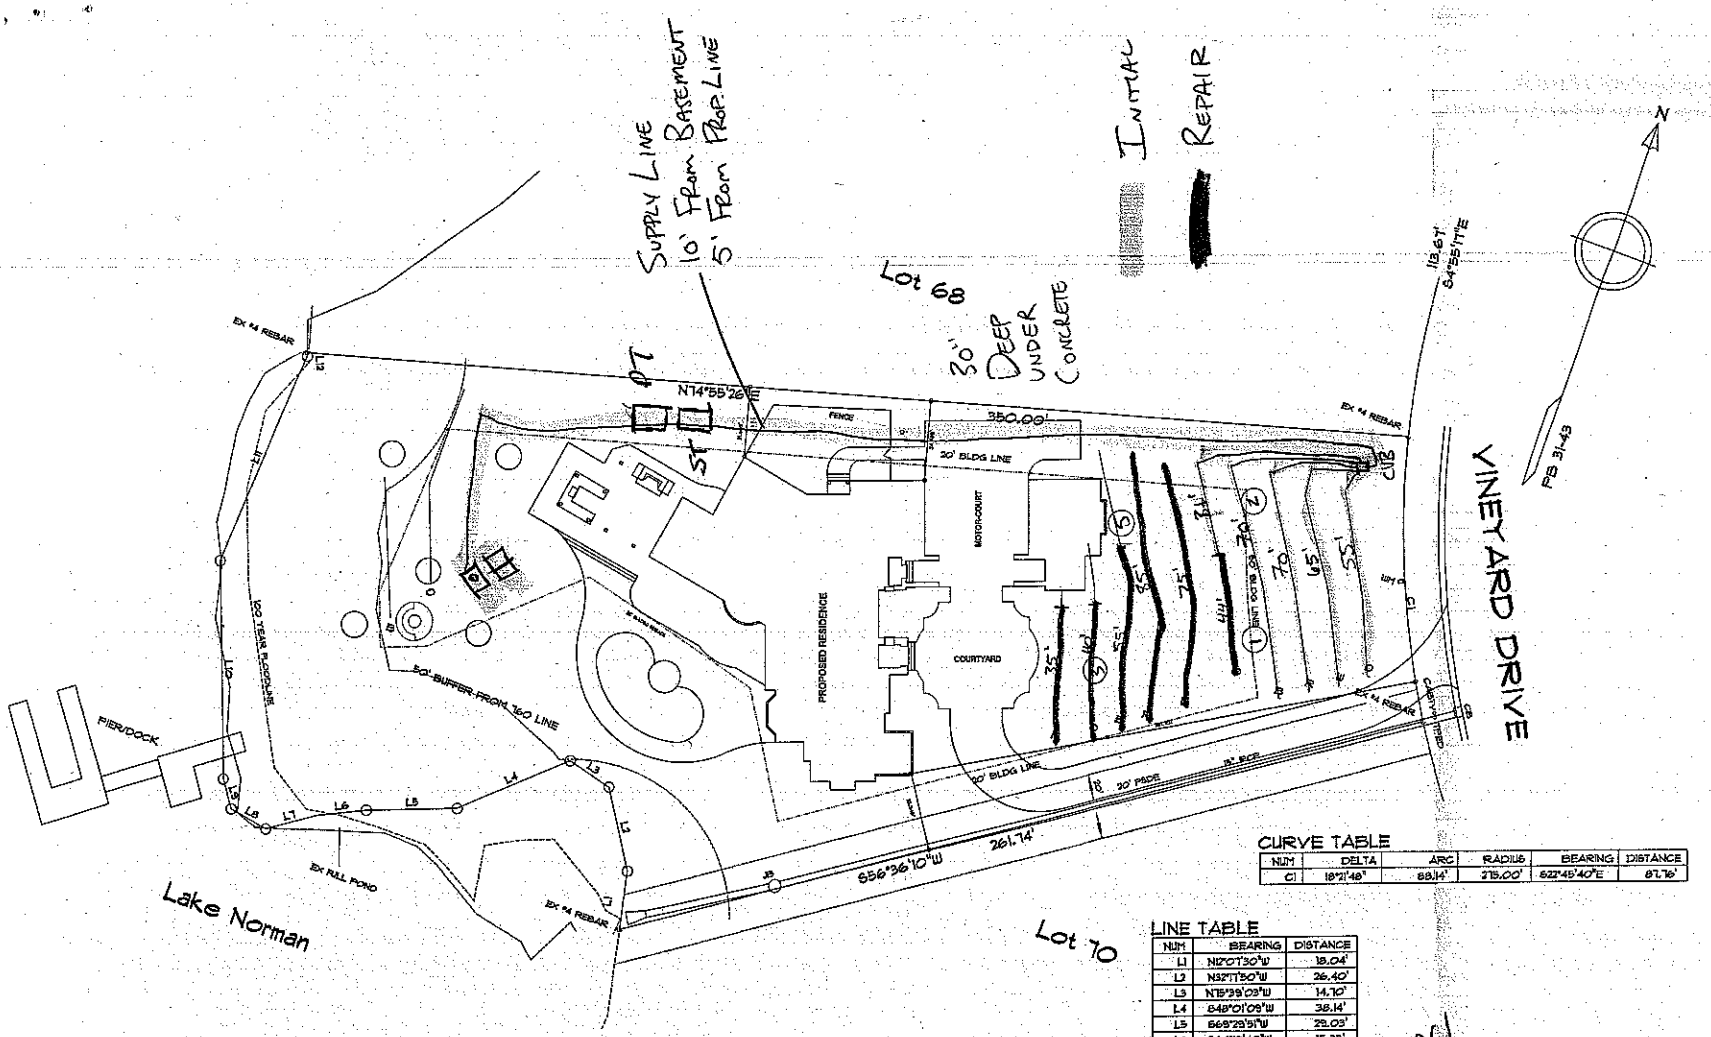

CURVE TABLE					
NUM	DELTA	ARC	RADIUS	BEARING	DISTANCE
C1	18°21'48"	88.14'	275.00'	S22°45'40"E	87.76'

LINE TABLE		
NUM	BEARING	DISTANCE
L1	N12°07'30"W	18.04'
L2	N32°11'50"W	26.40'
L3	N15°39'03"W	14.10'
L4	S48°01'09"W	38.14'
L5	S68°29'51"W	23.03'
L6	S64°19'40"W	15.38'
L7	S56°02'29"W	16.63'
L8	N30°27'14"W	12.62'
L9	N35°34'41"W	9.53'
L10	N21°02'49"W	67.13'
L11	N3°41'36"E	68.84'
L12	N19°54'10"W	1.16'

P.O. Box 651284 West Hill, NC 28227
tel: 704-545-2828 fax: 704-545-0800

PROJECT:

Lot 69, The Point

© COPYRIGHT 2013

DRAWN BY: J.U.BARJA
DATE: 12/20/2013
REVISED:

SHEET 1 OF 17