Pool # 207305 ✓

IREDELL COUNTY HEALTH DEPARTMENT

Statesville Office (704) 878-5305 Mooresville Office (704) 660-3625 PERMIT # 179080 (House)

IMPROVEMENT PERMIT / AUTHORIZATION TO CONSTRUCT / OPERATION PERMIT / EXISTING SYSTEM

✓ PIN # 4635-03-4538

APPLICANT: STONEBRIDGE LUXURY HOMES APPLICANT ADDRESS: PO Box 4297 MUILLE 28117

✓ SITE ADDRESS: 133 VINEYARD DR - Mvl. PHONE: 704-400-1235 ALT. PHONE:

SITE DIRECTIONS: BSR, THE POINT DR, TL VINEYARD

✓ SUBDIVISION: THE POINT ON NORMAN SECTION: 1A LOT # 69 LOT AREA: 1.112 AC DESIGN FLOW: 480 L.T.A.R.: .275

Septic Tank	1500 (gal)	STB	4499	Date	1-19-16	☒ New System ☐ Repair ☐ Expansion	System Type: I II III IV V VI	☒ Residence	No. Bedrooms 4
Pump Tank	1000 (gal)	PT	4717	Date	1-11-16	System Description:	LP- PANEL BLOCK	☐ Business	No. Persons
Pump Make	Orenco	Model	PF 500 511	Serial #	285-5005	Repair System Description:	SAME	☐ Other	No. Employees
# Nitrification Fields	1	# Lines	5	Linear Ft:	291'	Maintenance Agreement Required:	☒ YES ☐ NO	☐ Slab	☒ Crawl Space
Trench Width	24"	Max. Trench Bottom Depth	36"	Gravel Depth			☐ GRAVITY ☒ PRESSURE	☐ Basement w/plumbing	☐ Basement w/o plumbing

Water Supply: ☐ Private ☐ Public ☒ Community

Comments / Conditions:

3/1/16 Checked tanks. Tanks moved to side of house, meets all setbacks
3/7/16 Checked lines, installed essentially as drawn.

INITIAL SITE SKETCH

SEE ATTACHED DRAWING

BA

APPROVED MAY 13 2014

AS BUILT SKETCH

5/19/16 Set pressure, checked leak & alarm

Location of the proposed Inground pool addition does not appear to impact the existing on-site septic system or well. **NOTE: Must keep pool cut at least 15ft to Septic

Maria Dobson REHS Date: 12/16/14

ICHD-Environmental Health Division

207305

Permit can be suspended or revoked if any false information is supplied toward securing the permit / any unauthorized changes are made to the site / any unauthorized changes are made in the installation of the system. **CONTACT A LOCATOR SERVICE PRIOR TO ANY EXCAVATION**


☐ **IMPROVEMENT PERMIT** *with plat valid without expiration.* ☐ **IMPROVEMENT PERMIT** *with site plan valid for 60 mos.* ☐ **AUTHORIZATION TO CONSTRUCT** *valid for period equal to IMPROVEMENT PERMIT--not to exceed 60 mo.*

Owner / Applicant Signature: Date: 5-22-14 Installed by: Steve Jordan

IMPROVEMENT PERMIT by: BA Date: APPROVED MAY 13 2014 OPERATION PERMIT by: Maria Dobson RS Date: 5/19/16

AUTHORIZATION TO CONSTRUCT by: BA APPROVED MAY 13 2014 Existing System Inspected by: Date:

Health Dept. Copy - WHITE Applicant (Final Approval) - YELLOW Applicant (Conditional Approval) - PINK

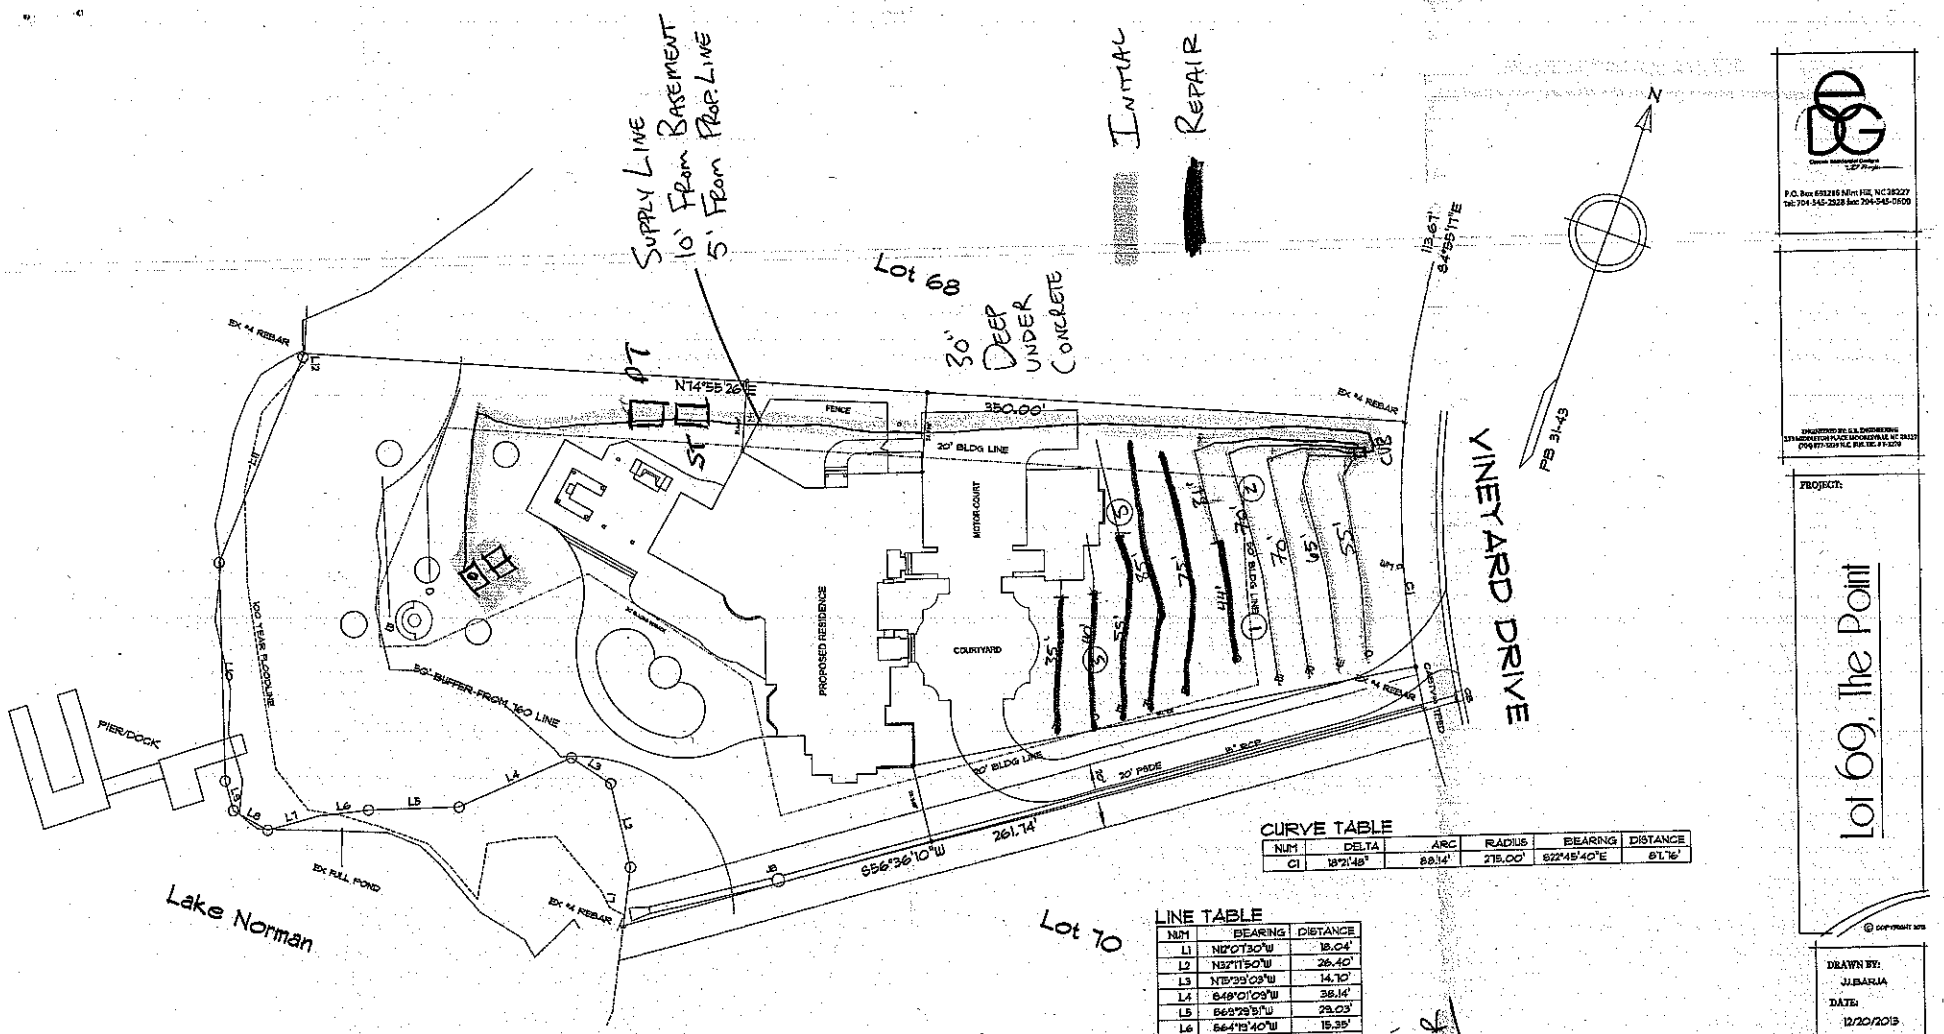

CURVE TABLE

NUM	DELTA	ARC	RADIUS	BEARING	DISTANCE
C1	18°21'48"	88.14'	275.00'	S22°45'40"E	87.76'

LINE TABLE

NUM	BEARING	DISTANCE
L1	N12°07'30"W	18.04'
L2	N32°11'50"W	26.40'
L3	N15°39'03"W	14.70'
L4	S49°01'09"W	38.14'
L5	S65°29'51"W	23.03'
L6	S64°13'40"W	15.35'
L7	S56°02'29"W	16.65'
L8	N80°27'14"W	12.62'
L9	N35°34'41"W	9.53'
L10	N21°02'48"W	67.13'
L11	N3°41'36"E	68.54'
L12	N85°54'10"W	1.16'

P.O. Box 691286 Mint Hill, NC 28227
tel: 704-545-2528 fax: 704-545-0800

PROJECT:

Lot 69, The Point

© COPYRIGHT 2015

DRAWN BY: JJ.BARJA
DATE: 12/20/2015
REVISED:

SHEET 1 OF 11