Start 2:00

IREDELL COUNTY HEALTH DEPARTMENT

STATESVILLE 704-878-5305 MOORESVILLE 704-664-5281

IMPROVEMENT PERMIT / AUTHORIZATION TO CONSTRUCT / OPERATION PERMIT / EXISTING SYSTEM INSPECTION

PERMIT# 071707 PIN# ~~4625947684~~ 4635034867 Jay JohnStone DATE 1/19/2001

OWNER OR CONTRACTOR CRI / Dienst Custom Homes PHONE: Business 309-8588 Home

ADDRESS

LOCATION Brawley School Rd TL The Pointe Dr/Meeting House TL Vineyard on right

SUBDIVISION The Pointe BLOCK / SECTION A LOT 67 LOT AREA 34,782 SITE CLASS PS DESIGN FLOW 480gpd L.T.A.R. .3

Septic Tank: 1000 Gallons; STB 338 Date 5/15/01
Pump Tank: 1000 Gallons; PT 27 Date 4/16/01
Pump Make: Model Serial No.
Nitrification Field: No Fields 1 Square Feet 1200' Linear Feet 400'
No Lines 4 at 100' Trench Width 36" Max Trench Bottom Depth 30"

☒ New System ☐ Repair System Type: I, II, III, IV, V, VI
System Description: pump - PM - 25% Reduction
Repair System Description: LP Panel Block
Maintenance Agreement Required: ☐ Yes ☒ No
Gravel Depth N/A ☐ Slab ☐ Crawl Space ☒ Basement w/plumbing ☐ Basement wo/plumbing


☒ House/Mod. Home No. Bedrooms 4
☐ Mobile Home No. Bathrooms 4
☐ Business No. Employees
☐ Other

Water Supply: ☐ Individual ☒ Public ☒ Community

Comments:/Conditions: Keep Septic System at least 10' from PL & 50' from Lake & 15' from Pool Keep tanks 15' from basement wall (side gradient) & Drainfield 25' upgradient of basement

Comments:/Conditions: Remove Old berms/terraces
* One inspection/observation port per 10/4/2001 Pres. Elect. & Alarm lateral
10/4/01

INITIAL SITE SKETCH

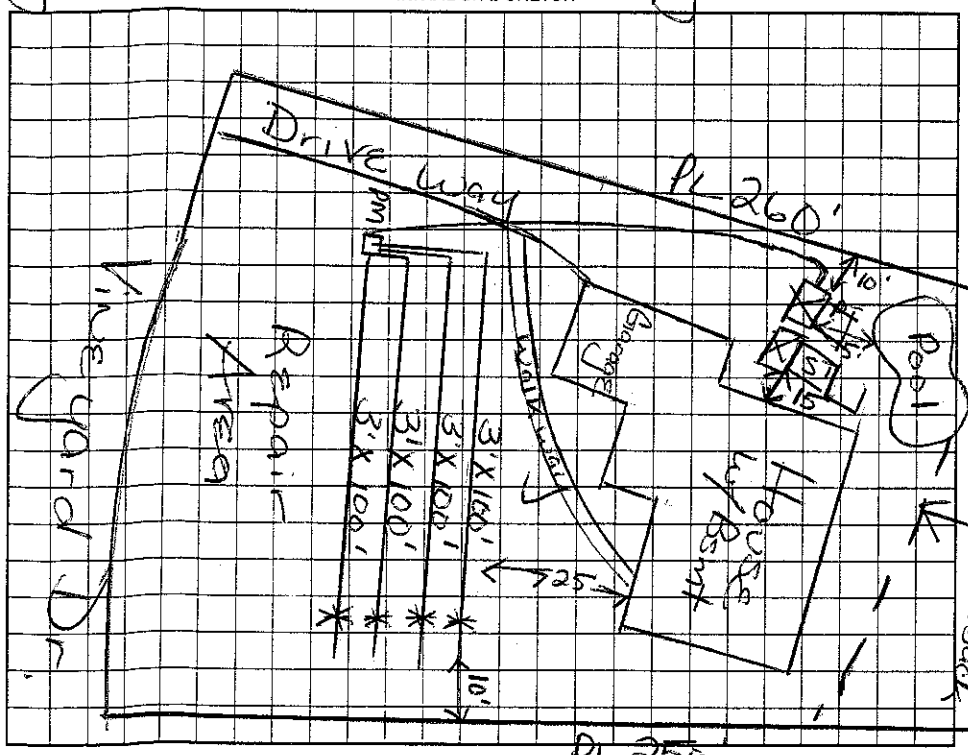

AS BUILT SKETCH

Drainfield installed as Drawn E-Z Flow Drainfield

Permit can be suspended or revoked if any false information is supplied toward securing the permit/any unauthorized changes are made to the site/any unauthorized changes are made in the installation of the system. Improvement Permit with plat valid without expiration. Improvement Permit with site plan valid for sixty months. Authorization to Construct is valid for a period equal to that of Improvement Permit – not to exceed sixty months.

Signed: Jay Johnstone date

Installed by: R & H

Improvement Permit by: Maria H. Dotson RS date 1/19/2001

Operation Permit by: Maria H. Dotson RS date 10/4/2001

Authorization to Construct by: Maria H. Dotson RS date 1/19/2001

Existing System Inspection by: date

HEALTH DEPT. COPY: WHITE OWNER COPY (FINAL): YELLOW OWNER COPY (INITIAL): PINK