IREDELL COUNTY HEALTH DEPARTMENT

Paid 50.00 CT

STATESVILLE 704-878-5305 MOORESVILLE 704-664-5281

IMPROVEMENT PERMIT / AUTHORIZATION TO CONSTRUCT / OPERATION PERMIT / EXISTING SYSTEM INSPECTION

PERMIT# 071795 PIN# ~~4625944084~~ 4635035448 DATE 8-16-2000

OWNER OR CONTRACTOR CRI - Simonini Builders PHONE: Business 358-9940 Home

ADDRESS 817 E Morehead Charlotte NC 28202-2705

LOCATION Brawley School Rd TR The Point Dr bear left on Meeting House Tl Vineyard Dr on Rt

SUBDIVISION The Point BLOCK / SECTION 14 LOT 70 LOT AREA 38,716 ft2 SITE CLASS. PSJ DESIGN FLOW 480gpd L.T.A.R. .3

Septic Tank: 1000 Gallons; STB 338 Date 2-22-01

Pump Tank: 1000 Gallons; PT 27 Date 3-9-01

Pump Make: Meyers Model ME3E Serial No.

Nitrification Field: No. Fields 1 Square Feet 1200' Linear Feet 400'

No Lines 5 at 80' Trench Width 36" Max Trench Bottom Depth 36" Gravel Depth N/A

[X] New System [ ] Repair System Type: I, II, III, IV, V, VI

System Description: Pumped - PM - 25% Reduction

Repair System Description: LP Paved Block

Maintenance Agreement Required: [ ] Yes [X] No Initially

[X] House/Mod. Home [ ] Mobile Home [ ] Business [ ] Other

No. Bedrooms 4 No. Bathrooms 6 No. Employees


[ ] Slab [ ] Crawl Space [X] Basement w/plumbing [ ] Basement wo/plumbing

Water Supply: [ ] Individual [X] Public [X] Community


Comments/Conditions: 25% Reduction in Drainfield area. Install one inspection port per drainline. Remove old beams/terraces.

Comments/Conditions: "Lake Storage" room can not be used as bedroom. Replaces permit issued 3/20/2000 Tanks exactly 10' from PL & 5' from House Tank hole actually below lake level.

Scale 1:50 INITIAL SITE SKETCH

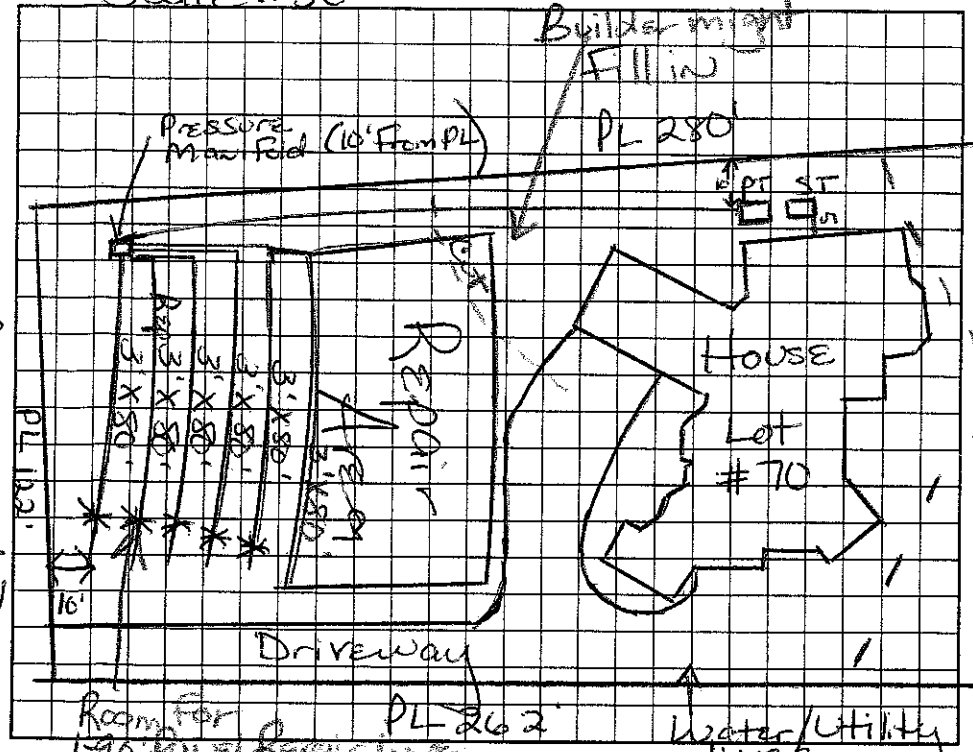

AS BUILT SKETCH

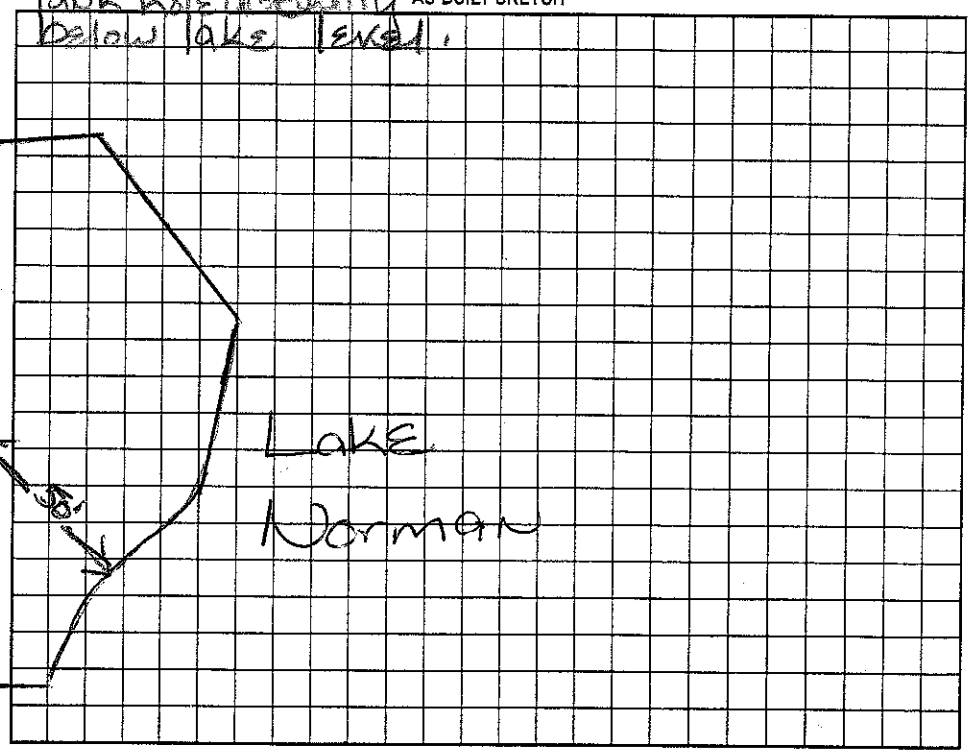

Permit can be suspended or revoked if any false information is supplied toward securing the permit/any unauthorized changes are made to the site/any unauthorized changes are made in the installation of the system. Improvement Permit with plat valid without expiration. Improvement Permit with site plan valid for sixty months. Authorization to Construct is valid for a period equal to that of Improvement Permit – not to exceed sixty months.

Signed: Beth Blum date 8/18/2000 Installed by: R & H

Improvement Permit by: Maria H. Dotson RS date 8/16/2000 Operation Permit by: Maria H. Dotson RS date 7/19/2001

Authorization to Construct by: Maria H. Dotson RS date 8/16/2000 Existing System Inspection by: date

HEALTH DEPT. COPY: WHITE OWNER COPY (FINAL): YELLOW OWNER COPY (INITIAL): PINK