Paid 50.00 Redraw

IREDELL COUNTY HEALTH DEPARTMENT

STATESVILLE 704-878-5305 MOORESVILLE 704-664-5281

IMPROVEMENT PERMIT / AUTHORIZATION TO CONSTRUCT / OPERATION PERMIT / EXISTING SYSTEM INSPECTION

PERMIT# 071703 PIN# 4625941684 4635036339 DATE 8-1-2000

OWNER OR CONTRACTOR Crescent Resources/David Dibble PHONE: Business David Dibble 892-8730 Home

ADDRESS P.O. Box 1003 Charlotte, NC

LOCATION Brawley School Rd TL The Pointe Dr TL Meeting House TL Vineyard on right

SUBDIVISION The Pointe BLOCK / SECTION 1A LOT 71 LOT AREA 33,438 ft² SITE CLASS: PS DESIGN FLOW 600 gpd T.A.R. .3

Septic Tank: 1500 Gallons; STB 338 Date 2/9/00
Pump Tank: 1500 Gallons; PT 338 Date 7/14/00
Pump Make: MYERS Model ME-50 S21 Serial No. 5/00
Nitrification Field: No Fields 1 Square Feet 1500' Linear Feet 500'
No Lines 5 at 100'ea Trench Width 36" Max Trench Bottom Depth 36" Gravel Depth N/A

☒ New System ☐ Repair System Type: I, II, III, IV, V, VI
System Description: Pumped-PM-25% Reduction
Repair System Description: Pump-Panel Blk
Maintenance Agreement Required: ☐ Yes ☒ No

☒ House/Mod. Home No. Bedrooms 5
☐ Mobile Home No. Bathrooms 4
☐ Business No. Employees
☐ Other


☐ Slab ☐ Crawl Space ☒ Basement w/plumbing ☐ Basement wo/plumbing

Water Supply: ☐ Individual ☒ Public ☒ Community


Comments:/Conditions: Keep Septic System 10' From PL & 50' From lake. Drainfield must be 25' upgradient of basement wall.

Comments:/Conditions: EZ Lay installed.

INITIAL SITE SKETCH Scale 1:50

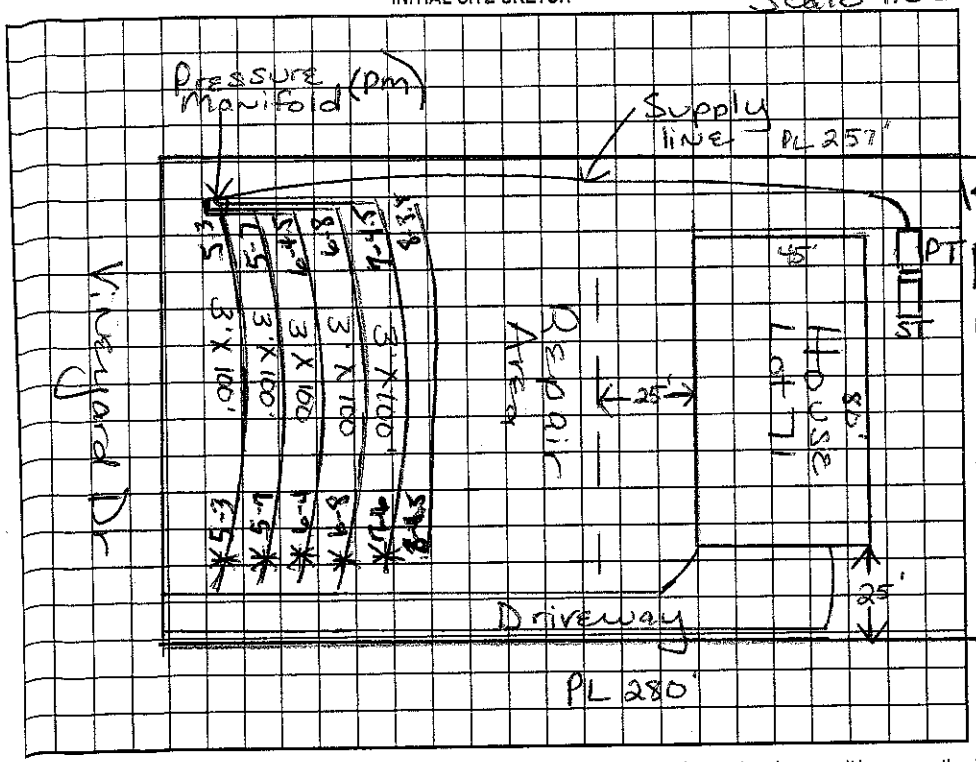

AS BUILT SKETCH

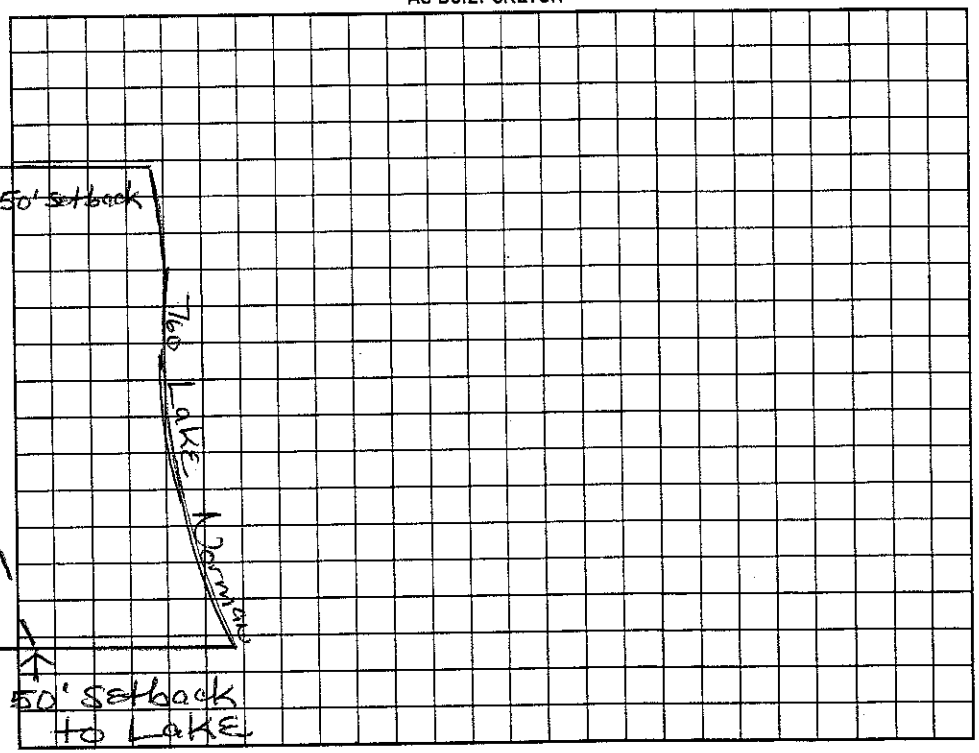

Permit can be suspended or revoked if any false information is supplied toward securing the permit/any unauthorized changes are made to the site/any unauthorized changes are made in the installation of the system. Improvement Permit with plat valid without expiration. Improvement Permit with site plan valid for sixty months. Authorization to Construct is valid for a period equal to that of Improvement Permit – not to exceed sixty months.

Signed: [signature] date 8/2/2000 Installed by: Orbison Compt. Co.

Improvement Permit by: Maria H. Tolson R.S. date 8/1/2000 Operation Permit by: Maria H. Tolson R.S. date 10/5/00

Authorization to Construct by: Maria H. Tolson R.S. date 8/1/2000 Existing System Inspection by: date

HEALTH DEPT. COPY: WHITE OWNER COPY (FINAL): YELLOW OWNER COPY (INITIAL): PINK