IREDELL COUNTY HEALTH DEPARTMENT

STATESVILLE 704-878-5305 MOORESVILLE 704-664-5281

IMPROVEMENT PERMIT / AUTHORIZATION TO CONSTRUCT / OPERATION PERMIT / EXISTING SYSTEM INSPECTION

PERMIT# 071758 PIN# 4625944684 4635-03-7188 DATE Aug 5, '98

OWNER OR CONTRACTOR Crescent Resources Inc. PHONE: Business Home

ADDRESS P.O. Box 1003 Charlotte

LOCATION Brawley School Rd. TL The Pointe Dr. Queen Anne Circle to Vineyard Dr. on Right @ jct w/ Falmouth Rd.

SUBDIVISION The Pointe BLOCK / SECTION 1A LOT 73 LOT AREA 40,360 ft² SITE CLASS. B DESIGN FLOW 440 gpd L.T.A.R. 0.25-0.3

Septic Tank: 1500 Gallons; STB 338 Date 4/11/00
Pump Tank: 1000 Gallons; PT 283 Date 9/20/00
Pump Make: MYERS Model ME50-5-21 Serial No. 25375DC09
Nitrification Field: No Fields 1 Square Feet 900 Linear Feet 300
No Lines 6 4 Trench Width 36" Max Trench Bottom Depth 30" Gravel Depth NA

☑ New System ☐ Repair System Type: I, II, III, IV, V, VI
System Description: LP Pump/Block
Repair System Description: LP Pump/Block
Maintenance Agreement Required: ☑ Yes ☐ No

☑ House/Mod. Home No. Bedrooms 4/4
☐ Mobile Home No. Bathrooms
☐ Business No. Employees
☐ Other

☑ Slab ☑ Crawl Space ☑ Basement w/plumbing ☐ Basement wo/plumbing


Water Supply: ☐ Individual ☑ Public ☐ Community

Comments:/Conditions: Remove old Burms / Terraces


Comments:/Conditions: (partial)
Feb 18, 2000 Rec'd house & site plan is substantially in compliance w/ I.P. - Sleeve under driveway as required. See attached plan. DRH.

1"=50'

INITIAL SITE SKETCH

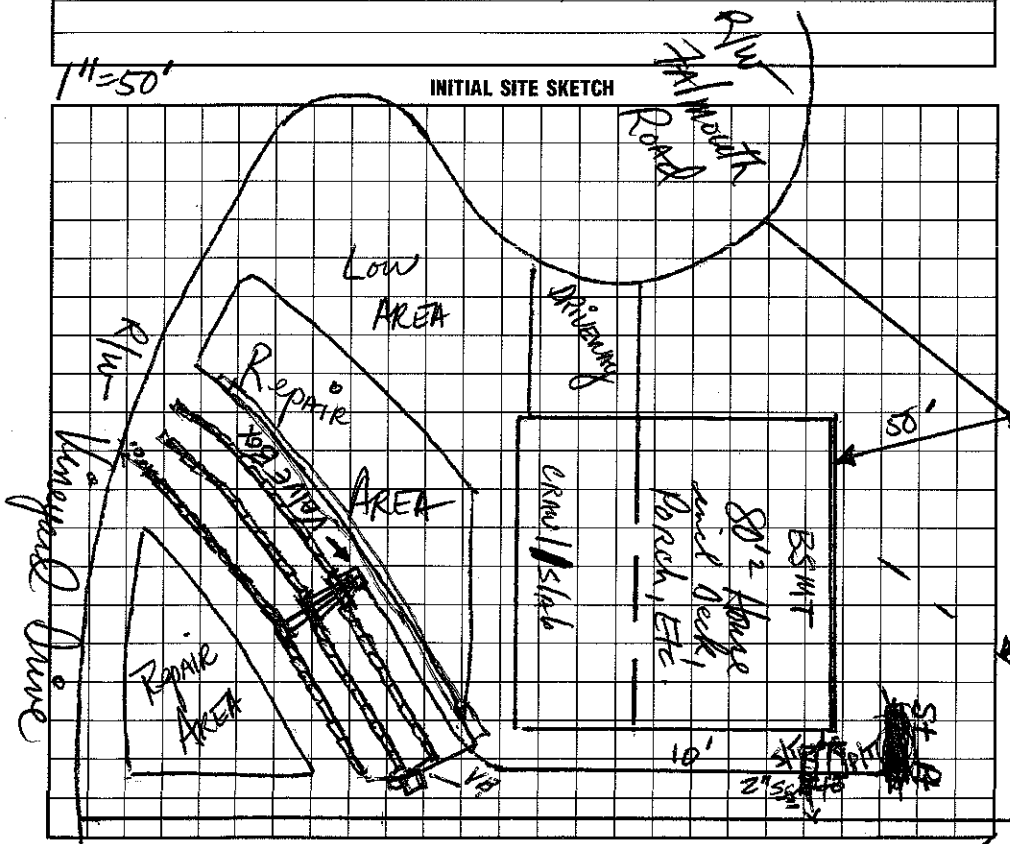

AS BUILT SKETCH

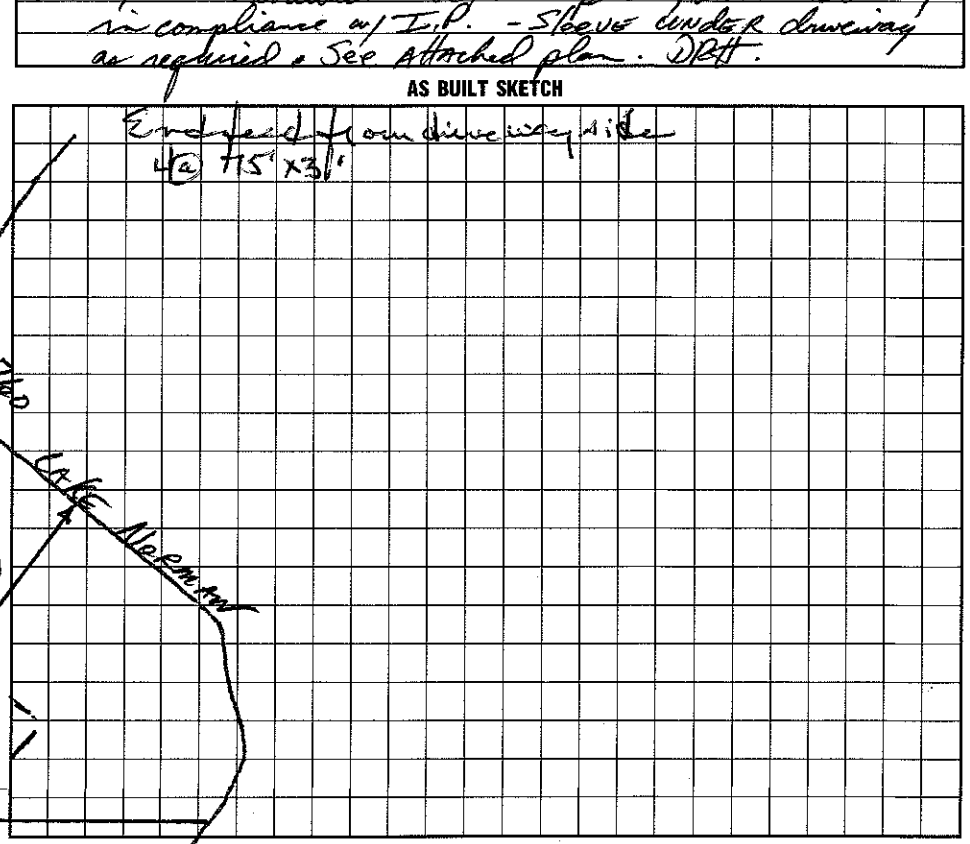

I understand that this permit can be suspended or revoked if any false information is supplied toward securing the permit/any unauthorized changes are made to the site/any unauthorized changes are made in the installation of the system. Improvement Permit with plat valid without expiration. Improvement Permit with site plan valid for sixty months. Authorization to Construct is valid for a period equal to that of Improvement Permit – not to exceed sixty months.

Signed: Paul G. Reynolds date 8-2-98 Installed by: Hensley Septic

Improvement Permit by: David R. Hinson RS date 8-5-98 Operation Permit by: Wesley Sparks RS. date 12/7/00

Authorization to Construct by: David R. Hinson RS date 2-16-00 Existing System Inspection by: date

HEALTH DEPT. COPY: WHITE INSPECTION COPY (FINAL): GREEN OWNER COPY (FINAL): YELLOW INSPECTION COPY (INITIAL): PINK OWNER COPY (INITIAL): GOLD