2.30

IREDELL COUNTY HEALTH DEPARTMENT

STATESVILLE 704-878-5305 MOORESVILLE 704-664-5281

IMPROVEMENT PERMIT / AUTHORIZATION TO CONSTRUCT / OPERATION PERMIT / EXISTING SYSTEM INSPECTION

PERMIT# 07705 PIN# 4625944684 4635037219 DATE Aug 5, '98

OWNER OR CONTRACTOR Crescent Resources Inc / Arcadia PHONE: Business Home

ADDRESS P.O. Box 1003 Charlotte

LOCATION Brawley Sch Rd. TL The Pointe Dr. Queen Anne Circle to Vineyard Drive on Right

SUBDIVISION The Pointe BLOCK / SECTION 1A LOT 72 LOT AREA 33,414 ft² SITE CLASS PS DESIGN FLOW 480gpd L.T.A.R. .3

Septic Tank: ~~1000~~ 1500 Gallons; STB ~~3-24-01~~ 338 Date 3-24-01

Pump Tank: 1000 Gallons; PT 27 Date 3-16-01

Pump Make: Model Serial No.

Nitrification Field: No Fields 1 Square Feet 1200 Linear Feet 400

No Lines 4@100' Trench Width 36" Max Trench Bottom Depth Gravel Depth

☑ New System ☐ Repair System Type: I, II, III, IV, V, VI

System Description: pumped-dp- 25% Reduction

Repair System Description: LP Panel Black

Maintenance Agreement Required: ☐ Yes ☑ No initially

☑ House/Mod. Home No. Bedrooms 4

☐ Mobile Home No. Bathrooms 4

☐ Business No. Employees

☐ Other

☐ Slab ☑ Crawl Space ☑ Basement w/plumbing ☐ Basement wo/plumbing


Water Supply: ☐ Individual ☑ Public ☑ Community

Comments:/Conditions: * ONE INSPECTION / OBSERVATION port per LATERAL
Remove old Burma / TERRACES.


Comments:/Conditions: (partial)
FILTER & RISER INSTALLED
REVIEWED HOUSE PLAN / LOOKS SUBSTANTIALLY AS SHOWN. Does Elect. a Alarm 8/23/01

1"=50'

INITIAL SITE SKETCH

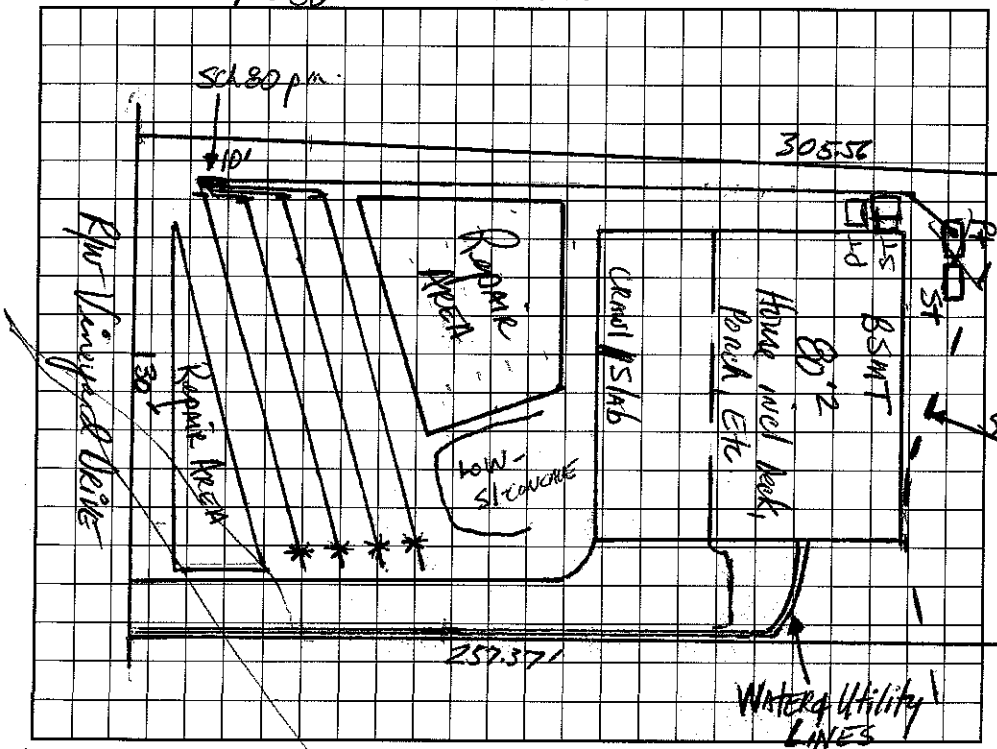

AS BUILT SKETCH

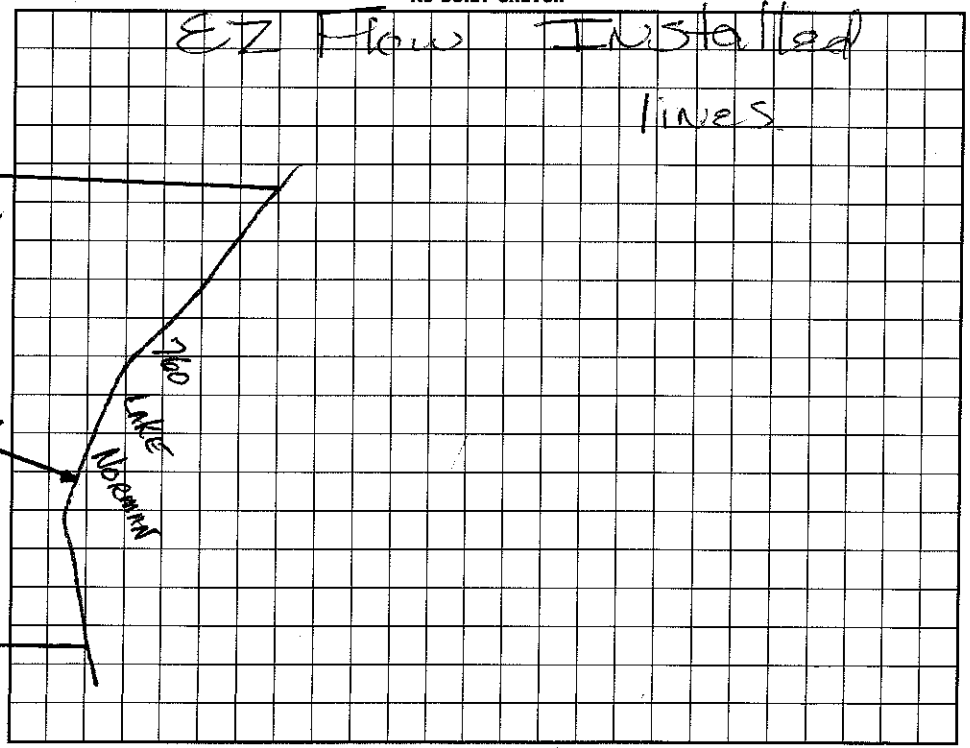

I understand that this permit can be suspended or revoked if any false information is supplied toward securing the permit/any unauthorized changes are made to the site/any unauthorized changes are made in the installation of the system. Improvement Permit with plat valid without expiration. Improvement Permit with site plan valid for sixty months. Authorization to Construct is valid for a period equal to that of Improvement Permit – not to exceed sixty months.

Signed: Paul G. Rogers date 8-24-98

Improvement Permit by: Mark R. Hinson IRS date 8-5-98

Authorization to Construct by: C. M. Freeman IRS date 9/2/98

Installed by: R & H Tanks

Operation Permit by: Maria H. Hall date 8/23/01

Existing System Inspection by: date

HEALTH DEPT. COPY: WHITE INSPECTION COPY (FINAL): GREEN OWNER COPY (FINAL): YELLOW INSPECTION COPY (INITIAL): PINK OWNER COPY (INITIAL): GOLD