11:00

IREDELL COUNTY HEALTH DEPARTMENT

STATESVILLE 704-878-5305 MOORESVILLE 704-664-5281

IMPROVEMENT PERMIT / AUTHORIZATION TO CONSTRUCT / OPERATION PERMIT / EXISTING SYSTEM INSPECTION

PERMIT# 072162 PIN# 4625941684 4635 03 7842 DATE August 1, '98

OWNER OR CONTRACTOR Crescent Resources Llc. // Cornerstone Bld. PHONE: Business _____ Home _____

ADDRESS P.O. Box 1003, Charlotte, N.C. 28202

LOCATION Brawley Sch Rd. TL The Pointe DRIVE Queen Anne Circle to Vineyard Ck. on left

SUBDIVISION The Pointe BLOCK / SECTION 1A LOT 43 LOT AREA 33,946 sq ft SITE CLASS. PS DESIGN FLOW 480gpd L.T.A.R. .3

Septic Tank: ~~1000~~ 1500 Gallons; STB 797 Date 6-7-98

Pump Tank: 1060 Gallons; PT 27 Date 8-18-98

Pump Make: _____ Model _____ Serial No. _____

Nitrification Field: No Fields 1 Square Feet 1200 Linear Feet 400

No Lines 4@100' Trench Width 36" Max Trench Bottom Depth 36" Gravel Depth N/A

☑ New System ☐ Repair System Type: I, II, III, IV, V, VI

System Description: pumped-pm- 25% Reduction

Repair System Description: LP Panel Block

Maintenance Agreement Required: ☐ Yes ☑ No initially

☑ House/Mod. Home No. Bedrooms 4

☐ Mobile Home No. Bathrooms 4

☐ Business No. Employees _____

☐ Other _____


☐ Slab ☑ Crawl Space ☐ Basement w/plumbing ☐ Basement wo/plumbing

Water Supply: ☐ Individual ☑ Public ☐ Community


Comments/Conditions: ~~X~~ ONE INSpection/Observation port per Lateral
Remove Any old Burms/TERRACES.

Comments/Conditions:

INITIAL SITE SKETCH 1"=50'

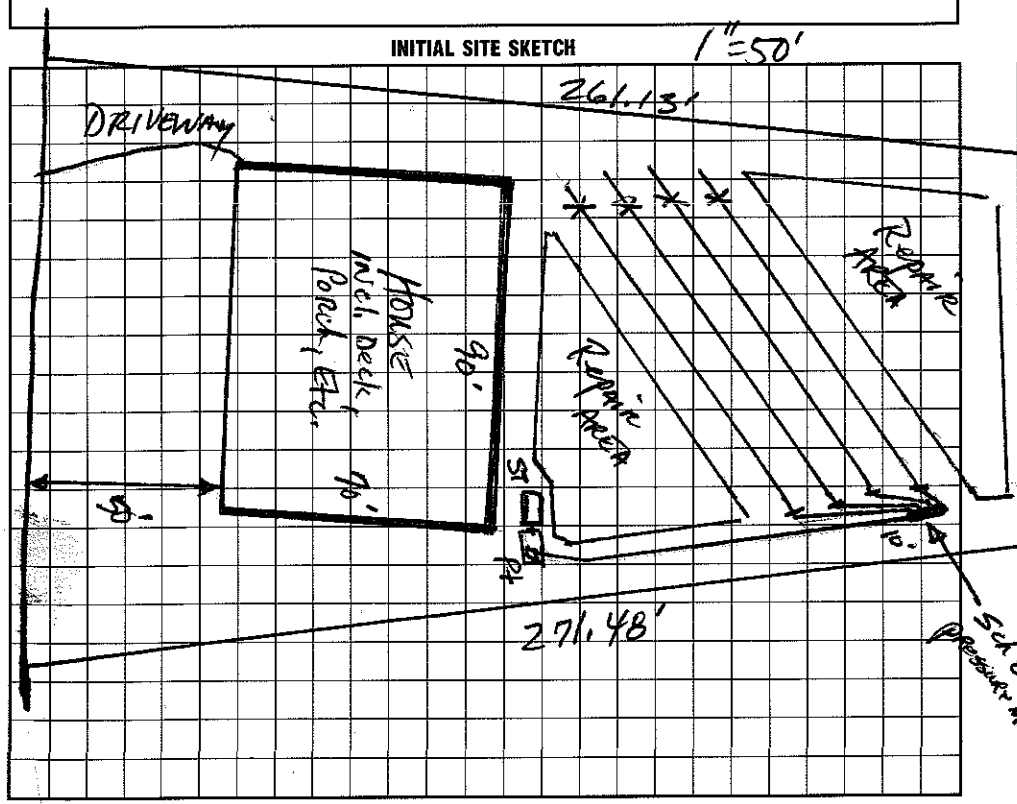

AS BUILT SKETCH

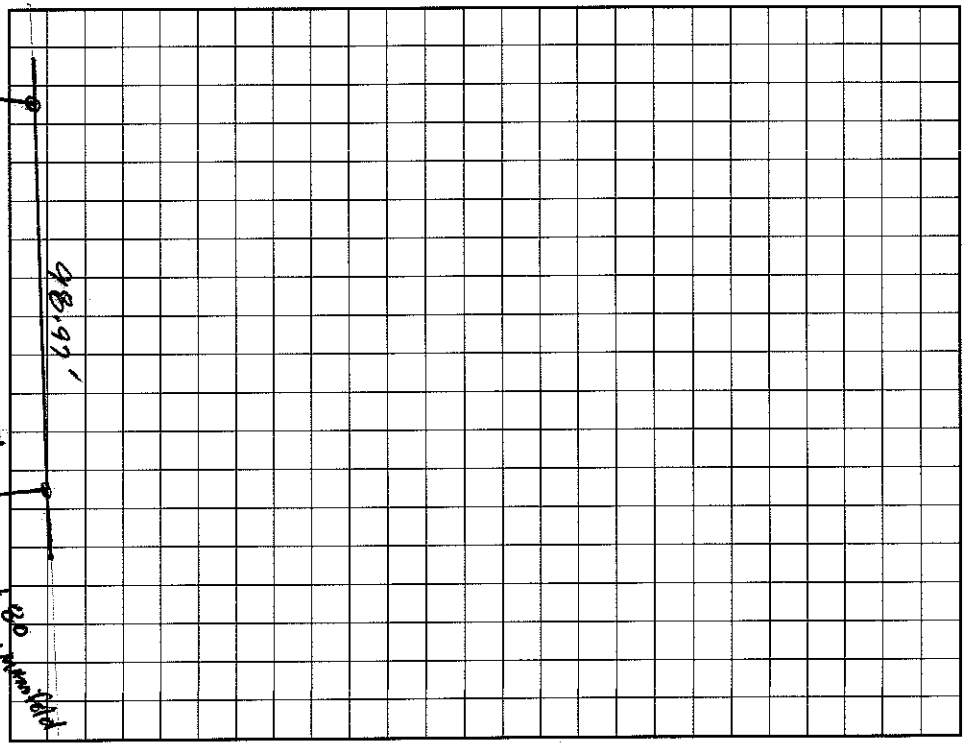

I understand that this permit can be suspended or revoked if any false information is supplied toward securing the permit/any unauthorized changes are made to the site/any unauthorized changes are made in the installation of the system. Improvement Permit with plat valid without expiration. Improvement Permit with site plan valid for sixty months. Authorization to Construct is valid for a period equal to that of Improvement Permit – not to exceed sixty months.

Signed: _____ date 8-20-98

Improvement Permit by: _____ date 8-1-98

Authorization to Construct by: _____ date 2-12-99

Installed by: C. Hedrick

Operation Permit by: _____ date 10/15/98

Existing System Inspection by: _____ date _____

HEALTH DEPT. COPY: WHITE INSPECTION COPY (FINAL): GREEN OWNER COPY (FINAL): YELLOW INSPECTION COPY (INITIAL): PINK OWNER COPY (INITIAL): GOLD