IREDELL COUNTY HEALTH DEPARTMENT

Statesville Office (704) 878-5305 Mooresville Office (704) 660-3625 PERMIT # 217395

IMPROVEMENT PERMIT / AUTHORIZATION TO CONSTRUCT / OPERATION PERMIT / EXISTING SYSTEM

PIN # 4635-03-8548

APPLICANT: Joseph Talton APPLICANT ADDRESS: 108 Ringneck Trail Mooresville, NC

SITE ADDRESS: 124 Vineyard Drive Mooresville, NC 28117 PHONE: 704-658-5204 ALT. PHONE:

SITE DIRECTIONS: BSR towards Lake Norman → Left around Meeting House (Trump Nat'l Golf Club), Left on Vineyard Dr. → House on Left

SUBDIVISION: The Point ON NORMAN SECTION: 1A LOT # 41 LOT AREA: 0.68 acres DESIGN FLOW: 480gal/day L.T.A.R.: Exist

Septic Tank	Exist (gal)	STB	Exist	Date	Exist
Pump Tank	Exist (gal)	PT	Exist	Date	Exist
Pump Make	—	Model	—	Serial #	—
# Nitrification Fields	Ex	# Lines	Ex	Linear Ft:	Ex
Trench Width	Ex	Max. Trench Bottom Depth	Ex	Gravel Depth	—

☐ New System ☐ Repair ☐ Expansion System Type: I II (III) IV V VI

System Description: Exist - 25% Reduction

Repair System Description: Exist - 30% LP-PPBPS

Maintenance Agreement Required: ☐ YES ☒ NO

☒ GRAVITY ☐ PRESSURE

☒ Residence ☐ Business ☐ Other ☐ Slab ☒ Crawl Space ☐ Basement w/plumbing ☐ Basement w/o plumbing


No. Bedrooms 4 No. Persons 8 No. Employees

Water Supply: ☐ Private ☒ Public ☒ Community

Comments / Conditions: Approval for a 43' x 22' inground pool as shown below. Construction access shall be from the driveway side of the house and NOT traverse any septic system components. Recommend pumping septic tank every 3-5 years.

ANY deviation in the size or location or layout of the pool from this plan voids this approval.

INITIAL SITE SKETCH

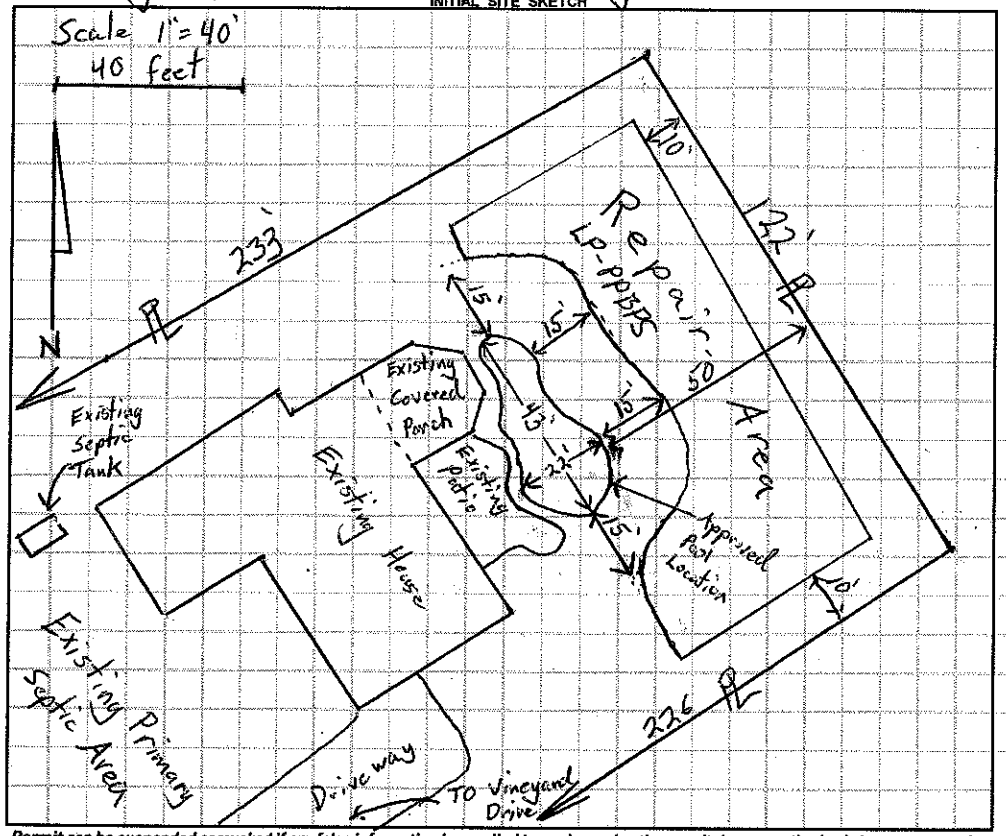

AS BUILT SKETCH

Permit can be suspended or revoked if any false information is supplied toward securing the permit / any unauthorized changes are made to the site / any unauthorized changes are made in the installation of the system. **CONTACT A LOCATOR SERVICE PRIOR TO ANY EXCAVATION**

☐ **IMPROVEMENT PERMIT *with plat*** *valid without expiration.* ☐ **IMPROVEMENT PERMIT *with site plan*** *valid for 60 mos.* ☐ **AUTHORIZATION TO CONSTRUCT** *valid for period equal to IMPROVEMENT PERMIT--not to exceed 60 mo.*

Owner / Applicant Signature: Joseph Talton Date: 4-28-16 Installed by:

IMPROVEMENT PERMIT by: Date: OPERATION PERMIT by: Date:

AUTHORIZATION TO CONSTRUCT by: Date: Existing System Inspected by: OS Thomas Shuck Date: 4-18-16

Health Dept. Copy - WHITE Applicant (Final Approval) - YELLOW Applicant (Conditional Approval) - PINK

49 - 25 = 24'

22' needed

