IREDELL COUNTY HEALTH DEPARTMENT

STATESVILLE 704-878-5305 $25.00 Paid MOORESVILLE 704-664-5281

IMPROVEMENT PERMIT / AUTHORIZATION TO CONSTRUCT / OPERATION PERMIT / EXISTING SYSTEM INSPECTION

PERMIT# 22406 PIN# 4635039396 DATE 7-15-05

OWNER OR CONTRACTOR Christian & Susan Werner PHONE: Business Home (704) 664-1806

ADDRESS 112 Vineyard Dr. Mooresville, NC 28117

LOCATION Brawley School Rd TR The Point Dr TL Vineyard on left near end

SUBDIVISION The Point BLOCK / SECTION 1A LOT 39 LOT AREA SITE CLASS PS DESIGN FLOW 480gpd L.T.A.R. .3

EXIST Septic Tank: 1500 Gallons; STB Date

Pump Tank: 1000 Gallons; PT Date

Pump Make: Model Serial No.

Install Add to Exist Nitrification Field: No Fields 1 Square Feet 270' Linear Feet 90'

No Lines 2 Trench Width 36" Max Trench Bottom Depth 36" Gravel Depth

☐ New System ☐ Repair System Type: I, II, III, IV, V, VI

System Description: Pump-LP-Panel Block Addition

Repair System Description: Pump-Off site -25%Red

Maintenance Agreement Required: ☐ Yes ☐ No

☒ House/Mod. Home No. Bedrooms 4

☐ Mobile Home No. Bathrooms 4

☐ Business No. Employees


☐ Other

☐ Slab ☐ Crawl Space ☐ Basement w/plumbing ☐ Basement wo/plumbing

Water Supply: ☐ Individual ☒ Public ☒ Community

Comments:/Conditions:


INITIAL SITE SKETCH

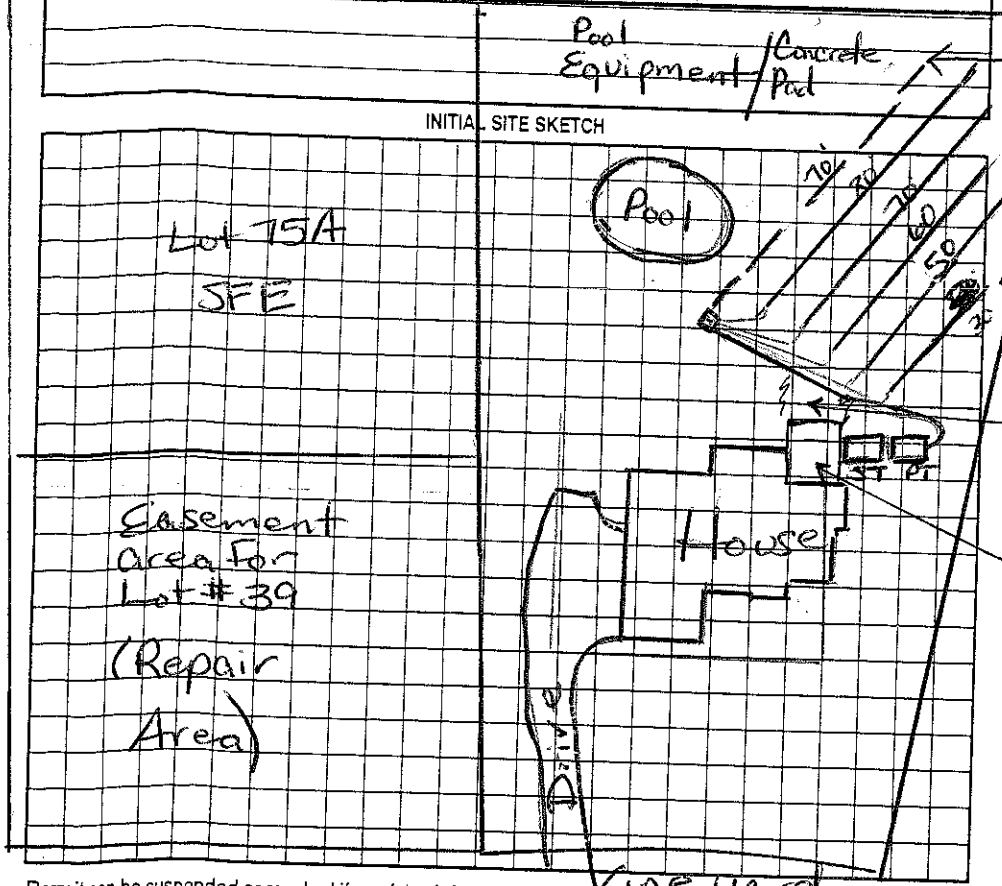

Comments:/Conditions: 11/1/05 Pressure set @ 2ft + New lines checked

Panel line abandoned - to close to pool cut

AS BUILT SKETCH

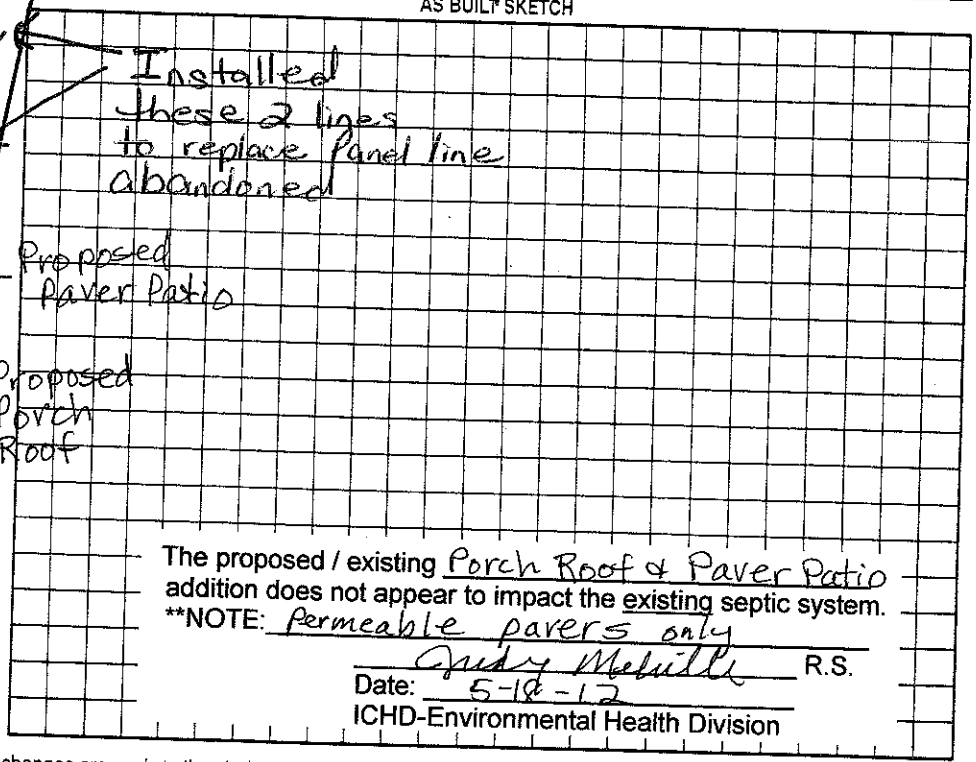

The proposed / existing Porch Roof & Paver Patio addition does not appear to impact the existing septic system.

**NOTE: Permeable pavers only

Cindy Melville R.S.

Date: 5-18-12

ICHD-Environmental Health Division

Permit can be suspended or revoked if any false information is supplied toward securing the permit/any unauthorized changes are made to the site/any unauthorized changes are made in the installation of the system. Improvement Permit with plat valid without expiration. Improvement Permit with site plan valid for sixty months. Authorization to Construct is valid for a period equal to that of Improvement Permit – not to exceed sixty months.

Signed: Joseph M. Neal RS date 6.9.05 Installed by: R & H

Improvement Permit by: Maria H. Dotson RS date 7/15/05 Operation Permit by: Maria H. Dotson RS date 11/1/05

Authorization to Construct by: Maria H. Dotson RS date 7/15/05 Existing System Inspection by: date

HEALTH DEPT. COPY: WHITE OWNER COPY (FINAL): YELLOW OWNER COPY (INITIAL): PINK