IREDELL COUNTY HEALTH DEPARTMENT

STATESVILLE 704-878-5305 MOORESVILLE 704-664-5281

(2,000)

IMPROVEMENT PERMIT / AUTHORIZATION TO CONSTRUCT / OPERATION PERMIT / EXISTING SYSTEM INSPECTION

PERMIT# 072157 PIN# 4625941684 DATE Aug 1, '98

OWNER OR CONTRACTOR Crescent Resources attn: SIMONINI Phone: Business _____ Home _____

ADDRESS PO Box 1003, Charlotte, N.C. 28202

LOCATION Brawley Sch Rd. TL The Pointe Dr. Queen Anne Circle to Vineyard Dr. on left near end

SUBDIVISION The Pointe BLOCK / SECTION 1A LOT 39 LOT AREA 26,441 ft² SITE CLASS PS DESIGN FLOW 480gpd L.T.A.R. .3

Septic Tank: 1500 Gallons; STB 7093 Date 12/16/99

Pump Tank: 1000 Gallons; PT 27 Date 5/30/99

Pump Make: ME3-F Model MYERS Serial No. 6/99

Nitrification Field: No Fields 1 Square Feet 840 Linear Feet 280

No Lines 4 Trench Width 36" Max Trench Bottom Depth ~30" Gravel Depth NA

☑ New System ☐ Repair System Type: I, II, III, IV, V, VI

System Description: LP Panel Block

Repair System Description: LP Panel Block

Maintenance Agreement Required: ☐ Yes ☐ No

☑ House/Mod. Home No. Bedrooms 4

☐ Mobile Home No. Bathrooms 4

☐ Business No. Employees ____

☐ Other ____

☐ Slab ☑ Crawl Space ☐ Basement w/plumbing ☐ Basement wo/plumbing

Water Supply: ☐ Individual ☑ Public ☐ Community

Comments:/Conditions: Remove any old berms/terraces


12-9-98 Reviewed site plan - appears in compliance w/ IP.

1"=50'


Comments:/Conditions:

MYERS ME50S-21 8/98

INITIAL SITE SKETCH

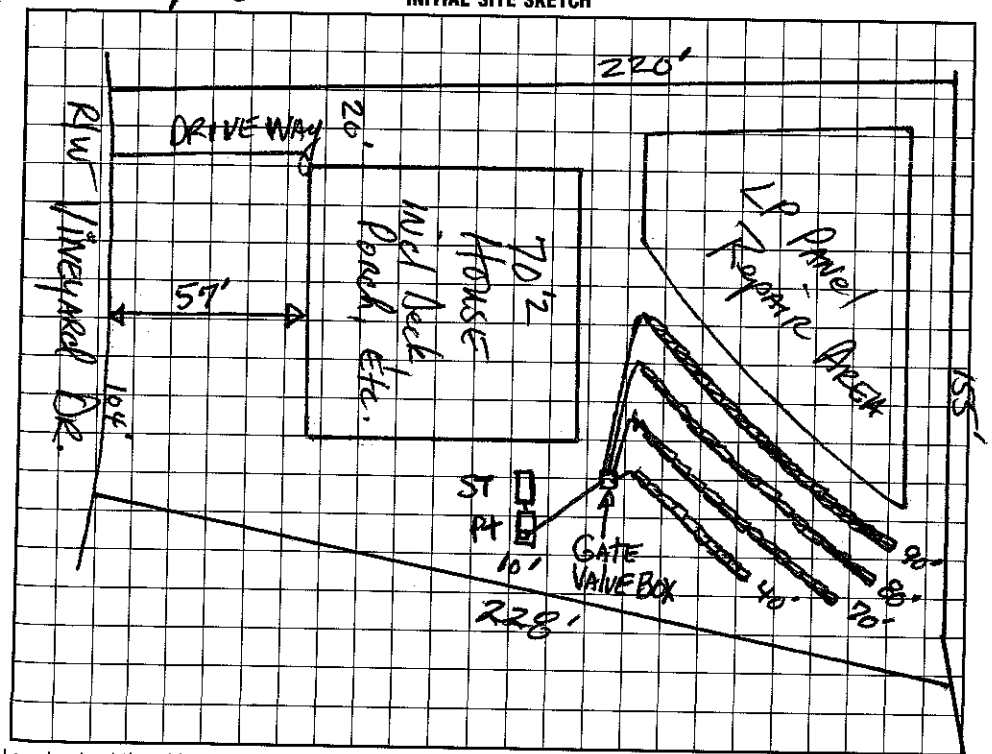

AS BUILT SKETCH

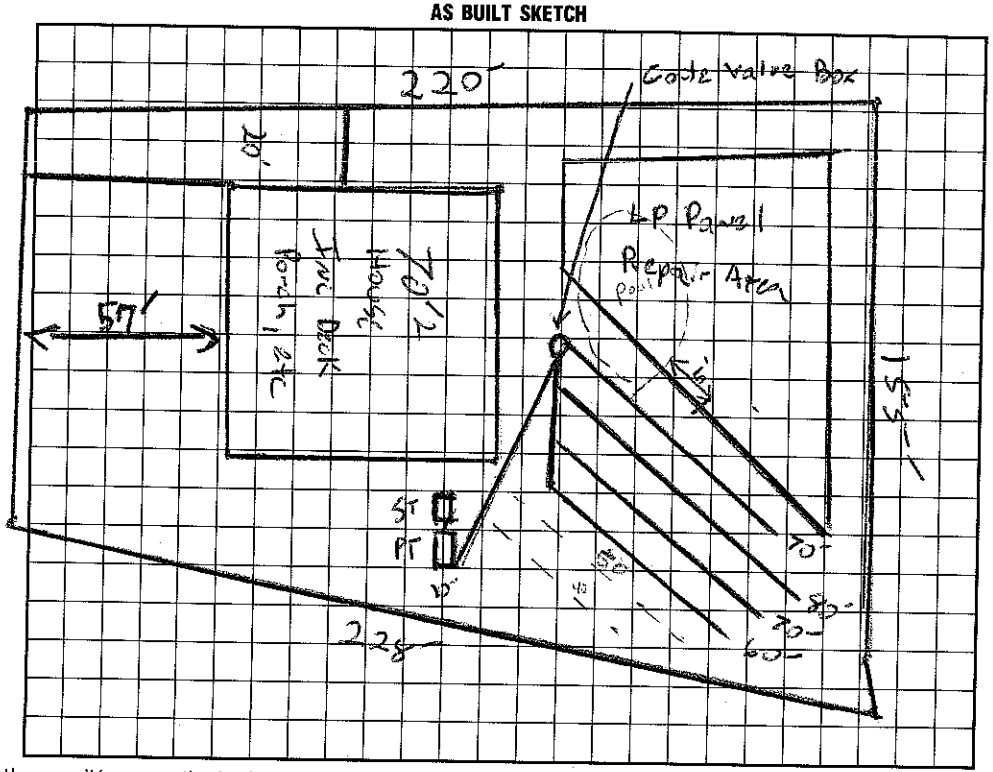

I understand that this permit can be suspended or revoked if any false information is supplied toward securing the permit/any unauthorized changes are made to the site/any unauthorized changes are made in the installation of the system. Improvement Permit with plat valid without expiration. Improvement Permit with site plan valid for sixty months. Authorization to Construct is valid for a period equal to that of Improvement Permit – not to exceed sixty months.

Signed: Paul G. Rogers date 8-20-98

Improvement Permit by: Donna B. Tinson, RS date 8-1-98

Authorization to Construct by: D. B. Tinson, RS date 12-9-98

Installed by: H + R Contracting

Operation Permit by: Wesley Spencer RS date 9/3/99

Existing System Inspection by: _____ date _____

HEALTH DEPT. COPY: WHITE INSPECTION COPY (FINAL): GREEN OWNER COPY (FINAL): YELLOW INSPECTION COPY (INITIAL): PINK OWNER COPY (INITIAL): GOLD