(2:00)*

# IREDELL COUNTY HEALTH DEPARTMENT

STATESVILLE 704-878-5305 MOORESVILLE 704-664-5281

**IMPROVEMENT PERMIT / AUTHORIZATION TO CONSTRUCT / OPERATION PERMIT / EXISTING SYSTEM INSPECTION**

PERMIT# 073393 PIN# 4625941684 (pt) 4635-04-0693 DATE May 19, '99

OWNER OR CONTRACTOR Crescent Resources Inc // Simonini Builders PHONE: Business 660-1185 Home

ADDRESS 2214 Brawley Sch Rd, Mooresville

LOCATION Brawley Sch Rd. TL The Point Drive Queen Anne to Easton Drive 3rd lot on right

SUBDIVISION The Point BLOCK / SECTION 1A LOT 4 LOT AREA 38,261 ft² SITE CLASS. PS DESIGN FLOW 480gpd L.T.A.R. ~.3

Septic Tank: ~~1000~~ 1500 Gallons; STB 797 Date 11-27-98
Pump Tank: 1000 Gallons; PT 27 Date 1-9-99
Pump Make: Model Serial No.
Nitrification Field: No Fields 1 Square Feet 900 Linear Feet 300
No Lines 3@100' Trench Width 36" Max Trench Bottom Depth ~30" Gravel Depth NA

☑ New System ☐ Repair System Type: I, II, III, (IV), V, VI
System Description: LP Panel Block
Repair System Description: SAME
Maintenance Agreement Required: ☑ Yes ☐ No


☑ House/Mod. Home No. Bedrooms 4
☐ Mobile Home No. Bathrooms 4
☐ Business No. Employees
☐ Other

☐ Slab ☑ Crawl Space ☐ Basement w/plumbing ☐ Basement wo/plumbing

Water Supply: ☐ Individual ☐ Public ☐ Community

Comments:/Conditions:

INITIAL SITE SKETCH 1"=50'

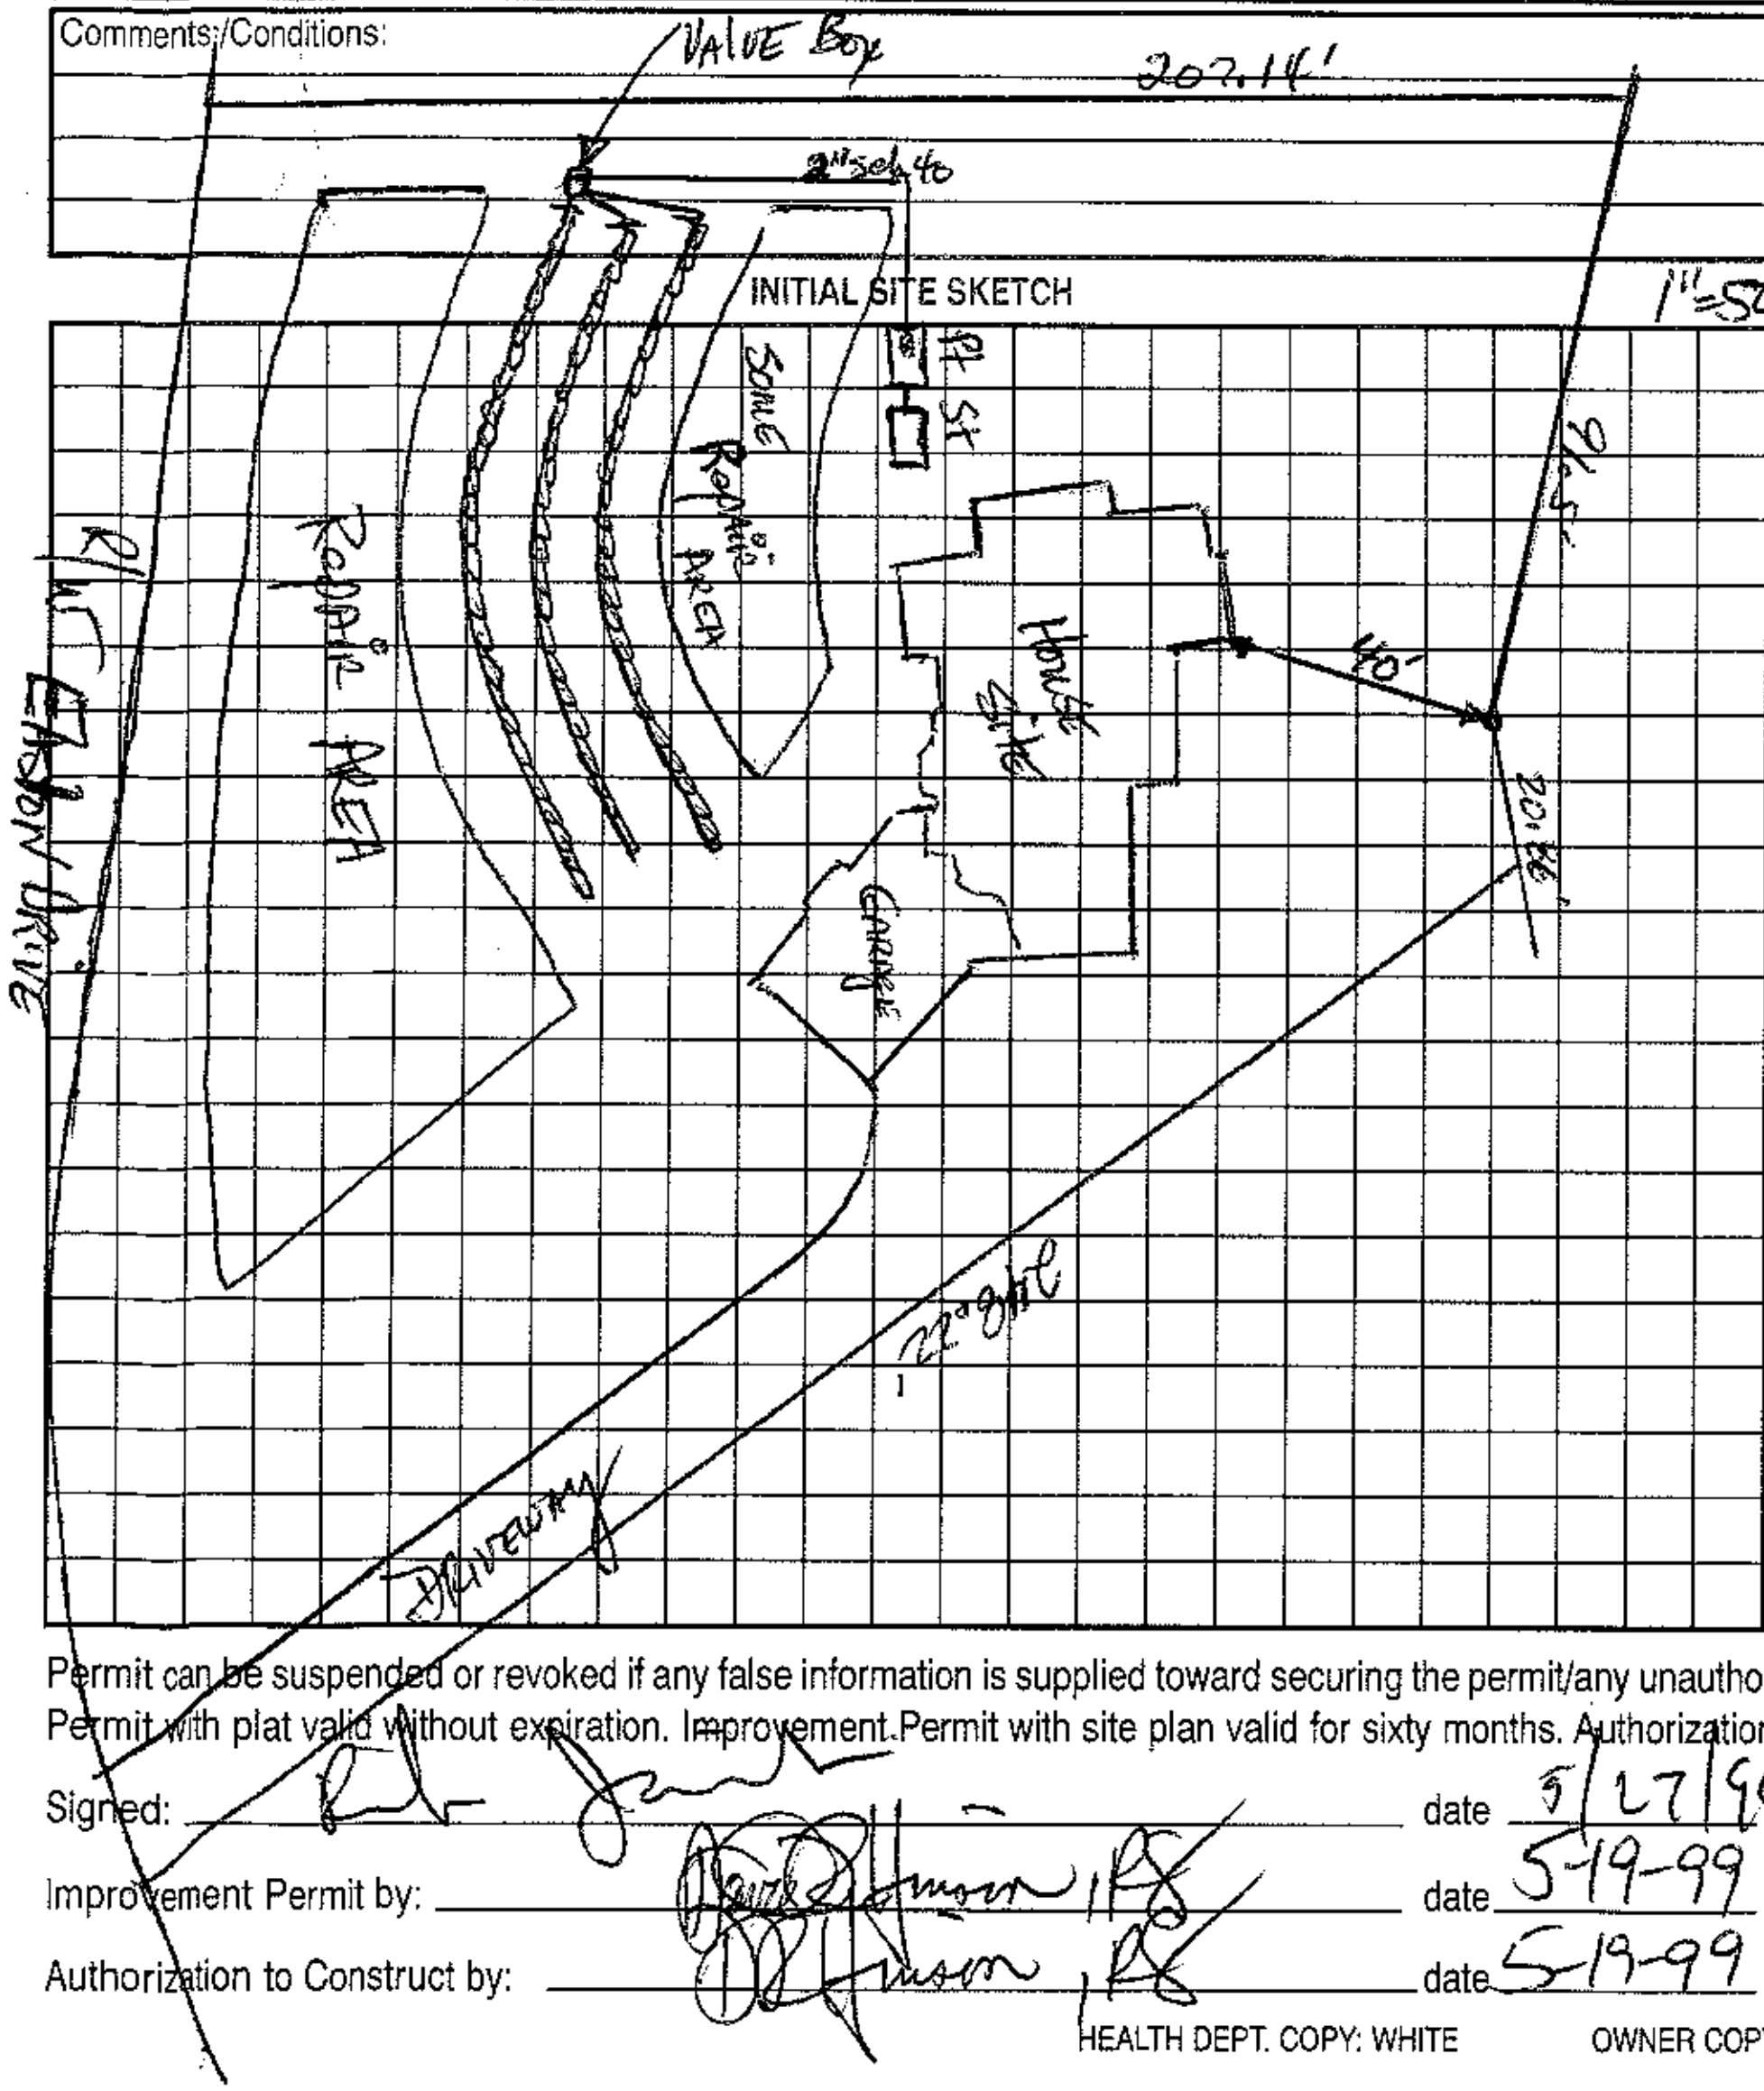


Comments:/Conditions: * Anti syphon hole required. This permit replaces earlier permit of 7-25-98. Redrawn to type 4 at request of builder to meet requirements of CRI/Tri-County W.W. Mgt.

AS BUILT SKETCH

Permit can be suspended or revoked if any false information is supplied toward securing the permit/any unauthorized changes are made to the site/any unauthorized changes are made in the installation of the system. Improvement Permit with plat valid without expiration. Improvement Permit with site plan valid for sixty months. Authorization to Construct is valid for a period equal to that of Improvement Permit – not to exceed sixty months.

Signed: [signature] date 5/27/99 Installed by: R&H Inc.

Improvement Permit by: [signature], RS date 5-19-99 Operation Permit by: Jeff Moyer date 8/11/99

Authorization to Construct by: [signature], RS date 5-19-99 Existing System Inspection by: date

HEALTH DEPT. COPY: WHITE OWNER COPY (FINAL): YELLOW OWNER COPY (INITIAL): PINK