IREDELL COUNTY HEALTH DEPARTMENT

STATESVILLE 704-878-5305 MOORESVILLE 704-

IMPROVEMENT PERMIT / AUTHORIZATION TO CONSTRUCT / OPERATION PERMIT / EXISTING SYST.

PERMIT# 2844 PIN# ~~4625441684~~ 4635-04-2000 DATE / /

OWNER OR CONTRACTOR CRESCENT RESOURCES INC. PHONE: Business Home

ADDRESS PO Box 1103 CHARLOTTE

LOCATION BRAWLEY SCHOOL RD. TO POINTE DR. QUEEN ANNE CIRCLE TO VINEYARD COURT

SUBDIVISION POINTE BLOCK / SECTION 1A LOT 65 LOT AREA 55712 ft² SITE CLASS. PS DESIGN FLOW 360 L.T.A.R. .3

Septic Tank: 1000 Gallons; STB 338 Date 4/7/00

Pump Tank: 1000 Gallons; PT 27 Date 2/3e/00

Pump Make: MYERS Model ME-50 Serial No.

Nitrification Field: No Fields 1 Square Feet 810 Linear Feet 280

No Lines 4@70' Trench Width 36" Max Trench Bottom Depth 30" Gravel Depth N/A

☑ New System ☐ Repair System Type: I, II, III, IV, V, VI

System Description: PUMP PANEL

Repair System Description: SAME

Maintenance Agreement Required: ☐ Yes ☐ No

☑ House/Mod. Home No. Bedrooms 4

☐ Mobile Home No. Bathrooms 4

☐ Business No. Employees

☑ Other

☐ Slab ☑ Crawl Space ☑ Basement w/plumbing ☐ Basement wo/plumbing

Water Supply: ☐ Individual ☑ Public ☑ Community

Comments:/Conditions:


Comments:/Conditions: Needs pressure test.

Installed as Drawn.

INITIAL SITE SKETCH



AS BUILT SKETCH

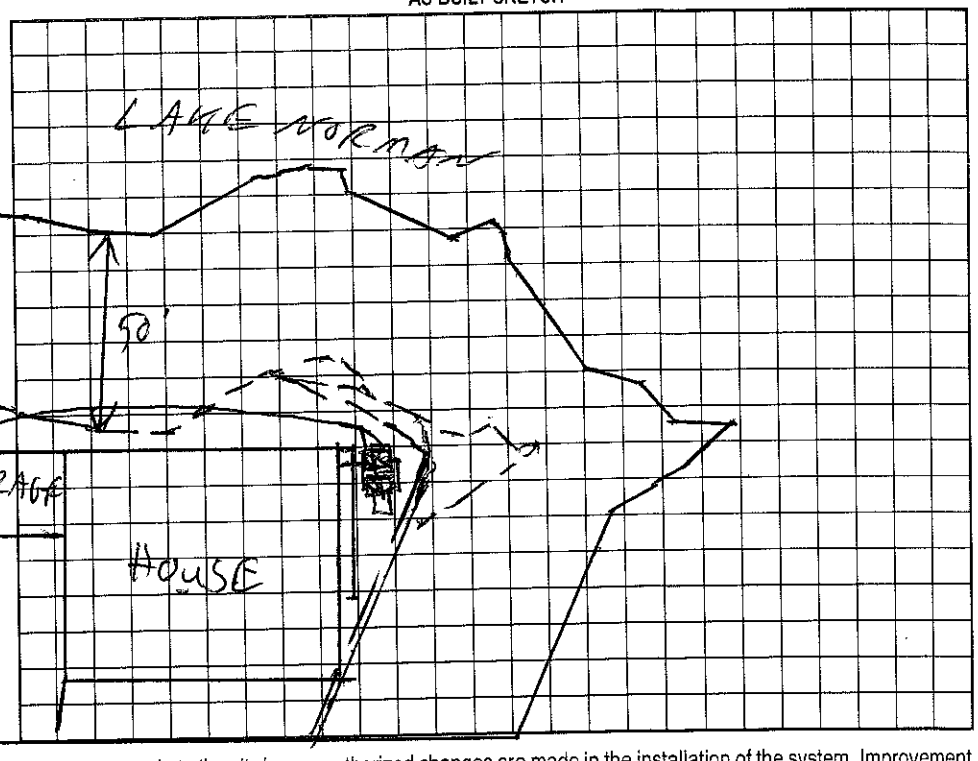

Permit can be suspended or revoked if any false information is supplied toward securing the permit/any unauthorized changes are made to the site/any unauthorized changes are made in the installation of the system. Improvement Permit with plat valid without expiration. Improvement Permit with site plan valid for sixty months. Authorization to Construct is valid for a period equal to that of Improvement Permit – not to exceed sixty months.

Signed: [signature] date 8-11-99 Installed by: R & H INC

Improvement Permit by: [signature] date 8/9/99 Operation Permit by: [signature] date 7/20/00

Authorization to Construct by: [signature] date 8/9/99 Existing System Inspection by: date

HEALTH DEPT. COPY: WHITE OWNER COPY (FINAL): YELLOW OWNER COPY (INITIAL): PINK