IREDELL COUNTY HEALTH DEPARTMENT

STATESVILLE 704-878-5305 MOORESVILLE 704-664-5281

IMPROVEMENT PERMIT / AUTHORIZATION TO CONSTRUCT / OPERATION PERMIT / EXISTING SYSTEM INSPECTION

PERMIT# 071969 PIN# 4625941684 4635-04-2559 DATE July 25, '98

OWNER OR CONTRACTOR Crescent Resources & Inc. // LN Signature Homes PHONE: Business _____ Home _____

ADDRESS P.O. Box 1003, Charlotte

LOCATION Brawley Sch Rd. TL The Pointe Dr. Queen Anne Circle to Easton Drive 4th lot on Right

SUBDIVISION The Pointe BLOCK / SECTION 1A LOT 5 LOT AREA 31,682 ft² SITE CLASS PS DESIGN FLOW 480gpd L.T.A.R. ~.3

Septic Tank: 1500 Gallons; STB 797 Date 7/4/99
Pump Tank: _____ Gallons; PT _____ Date _____
Pump Make: _____ Model _____ Serial No. _____
Nitrification Field: No Fields 1 Square Feet 1200 Linear Feet 407
No Lines 4 @ 100' Trench Width 36" Max Trench Bottom Depth 36" Gravel Depth NA

☑ New System ☐ Repair System Type: I, II, III, IV, V, VI
System Description: Gravity 25% Reduction
Repair System Description: LP Panel Block
Maintenance Agreement Required: ☐ Yes ☑ No initially


☑ House/Mod. Home ☐ Mobile Home ☐ Business ☐ Other
No. Bedrooms 4 No. Bathrooms 4 No. Employees ____
☐ Slab ☑ Crawl Space ☐ Basement w/plumbing ☐ Basement wo/plumbing

Water Supply: ☐ Individual ☑ Public ☐ Community

Comments:/Conditions: Septic System Installer to follow material specifications in "The Pointe Wastewater Disposal Manual"
* ONE inspection/observation port per Lateral
Remove old Burrows/Terraces

Comments:/Conditions: 12-23-98 Renewed house & site plan. Appears in compliance w/ IP - DRH

INITIAL SITE SKETCH 1" = 50'

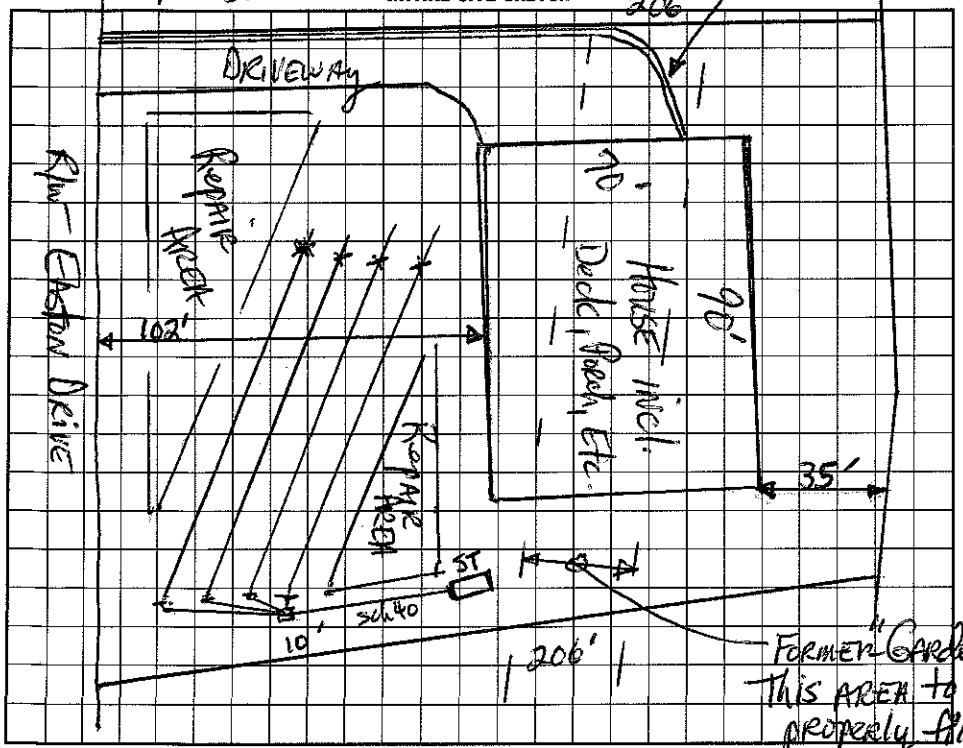

AS BUILT SKETCH

I understand that this permit can be suspended or revoked if any false information is supplied toward securing the permit/any unauthorized changes are made to the site/any unauthorized changes are made in the installation of the system. Improvement Permit with plat valid without expiration. Improvement Permit with site plan valid for sixty months. Authorization to Construct is valid for a period equal to that of Improvement Permit – not to exceed sixty months.

Signed: _____ date 8-20-98 Installed by: H & R Contracting

Improvement Permit by: _____ date 7-25-98 Operation Permit by: Wesley Sparks RS date 9/8/99

Authorization to Construct by: _____ date 12-23-98 Existing System Inspection by: _____ date _____

HEALTH DEPT. COPY: WHITE INSPECTION COPY (FINAL): GREEN OWNER COPY (FINAL): YELLOW INSPECTION COPY (INITIAL): PINK OWNER COPY (INITIAL): GOLD