(230)

IREDELL COUNTY HEALTH DEPARTMENT

STATESVILLE 704-878-5305 MOORESVILLE 704-664-5281

IMPROVEMENT PERMIT / AUTHORIZATION TO CONSTRUCT / OPERATION PERMIT / EXISTING SYSTEM INSPECTION

PERMIT# 07652 PIN# 4625446684 4635-04-3815 DATE Aug 29 98

OWNER OR CONTRACTOR Crescent Resources, Inc / Arcadia Homes PHONE: Business _____ Home _____

ADDRESS P.O. Box 1003, Charlotte

LOCATION Brawley Sch Rd. Rt The Pointe DR. Queen Anne Circle to Easton DR. on left

SUBDIVISION The Pointe BLOCK / SECTION 1A LOT 121 LOT AREA 32,914 ft² SITE CLASS. PS DESIGN FLOW 480gpd L.T.A.R. 2003

Septic Tank: 1000 Gallons; STB 338 Date 1/7/00

Pump Tank: 1000 Gallons; PT 27 Date 2/19/98

Pump Make: MEIERS Model MEIERS-21 Serial No. _____

Nitrification Field: No Fields 1 Square Feet 810 Linear Feet 270

No Lines 3@90' Trench Width 36" Max Trench Bottom Depth 30" Gravel Depth N/A

☑ New System ☐ Repair System Type: I, II, III, IV, V, VI

System Description: LP Panel Block

Repair System Description: LP Panel Block

Maintenance Agreement Required: ☑ Yes ☐ No

☑ House/Mod. Home No. Bedrooms 4

☐ Mobile Home No. Bathrooms 4

☐ Business No. Employees 1

☐ Other _____

☑ Slab ☑ Crawl Space ☑ Basement w/plumbing ☐ Basement w/o plumbing

Water Supply: ☐ Individual ☑ Public ☐ ~~Community~~

Comments/Conditions: Properly fill eroded and gullied areas. Remove any old burns, trenches.


Jan 8, '99 - House & Site plan reviewed - Appears in compliance w/ IP. Alarm box & Elect checked 4/24/2000

Comments/Conditions: (PARTIAL) ~~NO FILTER~~ ~~No Pressure~~ Pressure Checked 4/24/2000


Alarm box & Elect Checked 4/24/2000

1"=50'

INITIAL SITE SKETCH

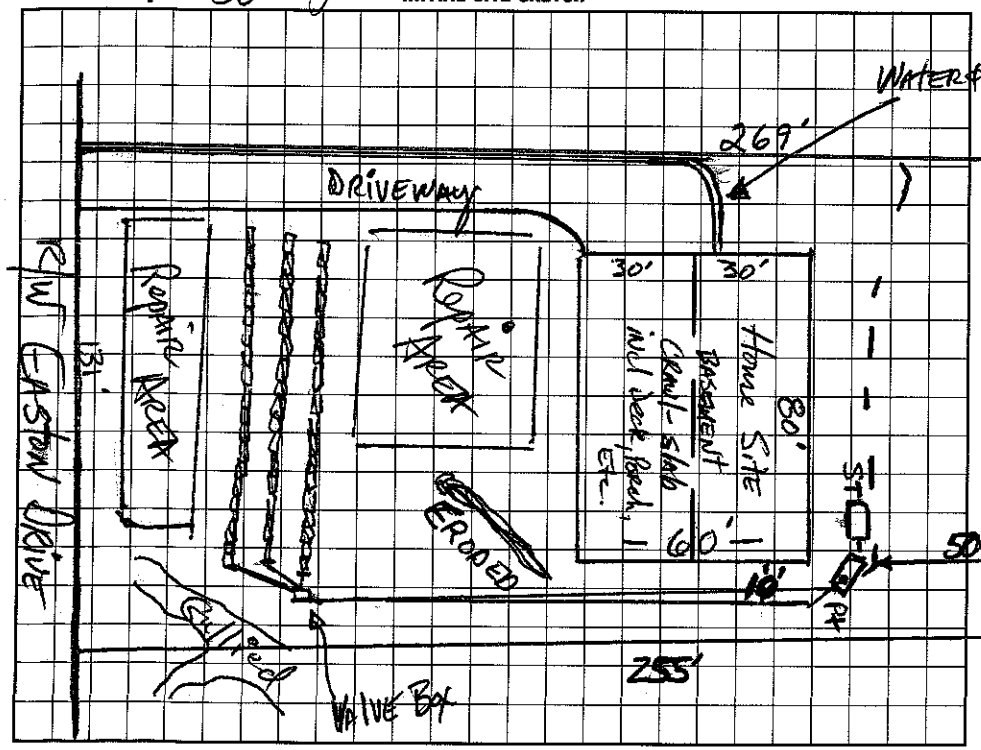

AS BUILT SKETCH

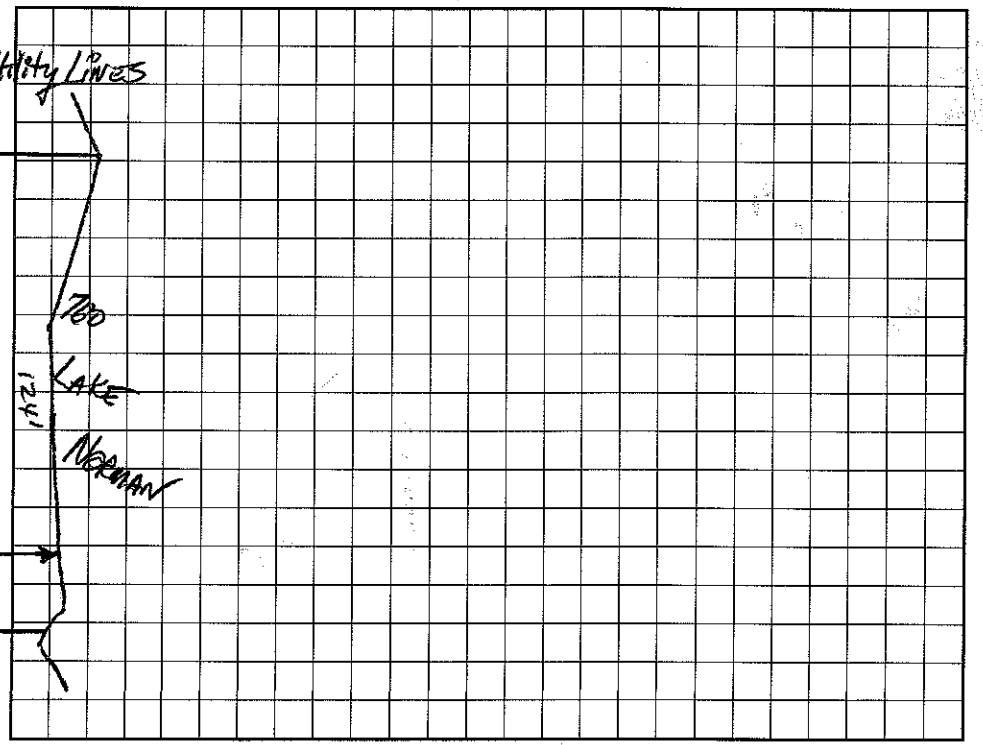

I understand that this permit can be suspended or revoked if any false information is supplied toward securing the permit/any unauthorized changes are made to the site/any unauthorized changes are made in the installation of the system. Improvement Permit with plat valid without expiration. Improvement Permit with site plan valid for sixty months. Authorization to Construct is valid for a period equal to that of Improvement Permit – not to exceed sixty months.

Signed: _____ date 8/24/98

Improvement Permit by: David B. Thompson, RS date 8-20-98

Authorization to Construct by: David B. Thompson, RS date 1-8-99

Installed by: R&H Grading

Operation Permit by: Maria H. Wilson, RS date 4/24/2000

Existing System Inspection by: _____ date _____

HEALTH DEPT. COPY: WHITE INSPECTION COPY (FINAL): GREEN OWNER COPY (FINAL): YELLOW INSPECTION COPY (INITIAL): PINK OWNER COPY (INITIAL): GOLD