3:30 - 4:00

IREDELL COUNTY HEALTH DEPARTMENT

STATESVILLE 704-878-5305 MOORESVILLE 704-664-5281

IMPROVEMENT PERMIT / AUTHORIZATION TO CONSTRUCT / OPERATION PERMIT / EXISTING SYSTEM INSPECTION

PERMIT# 071706 PIN# 4625944684 4635-04-4002 DATE Aug 4, '98

OWNER OR CONTRACTOR Crescent Resources, LLC / Darrell Custom Homes PHONE: Business Home

ADDRESS P.O. Box 1003 Charlotte

LOCATION Brawley Sch Rd. TL The Pointe Drive Queen Anne Circle to Vineyard Drive on Right

SUBDIVISION The Pointe BLOCK / SECTION 1A LOT 66 LOT AREA 45,067 ft² SITE CLASS. PS DESIGN FLOW 400 gpd L.T.A.R. .2-.3

Septic Tank: 1000 Gallons; STB 338 Date 2-10-00 ☑ New System ☐ Repair System Type: I, II, III, IV, V, VI

Pump Tank: 1000 Gallons; PT 27 Date 12-17-99 System Description: LP Panel Black

Pump Make: Meyers Model ME 50 Serial No. Repair System Description: LP Panel Black

Nitrification Field: No Fields 1 Square Feet 990 Linear Feet 330 Maintenance Agreement Required: ☑ Yes ☐ No

No Lines 6@55' Trench Width 36" Max Trench Bottom Depth 30" Gravel Depth NA

☑ House/Mod. Home No. Bedrooms 4/4

☐ Mobile Home No. Bathrooms

☐ Business No. Employees

☐ Other

☐ Slab ☑ Crawl Space ☑ Basement w/plumbing ☐ Basement wo/plumbing


Water Supply: ☐ Individual ☑ Public ☑ Community

Comments:/Conditions:
Remove Old Burms/Terraces

Comments:/Conditions:
9-2-99 Reviewed house + site plan - appears substantially in compliance w/ IP even with basement. DRH
Lines & tanks Checked 3/15/2000 MD

1"=50'

INITIAL SITE SKETCH

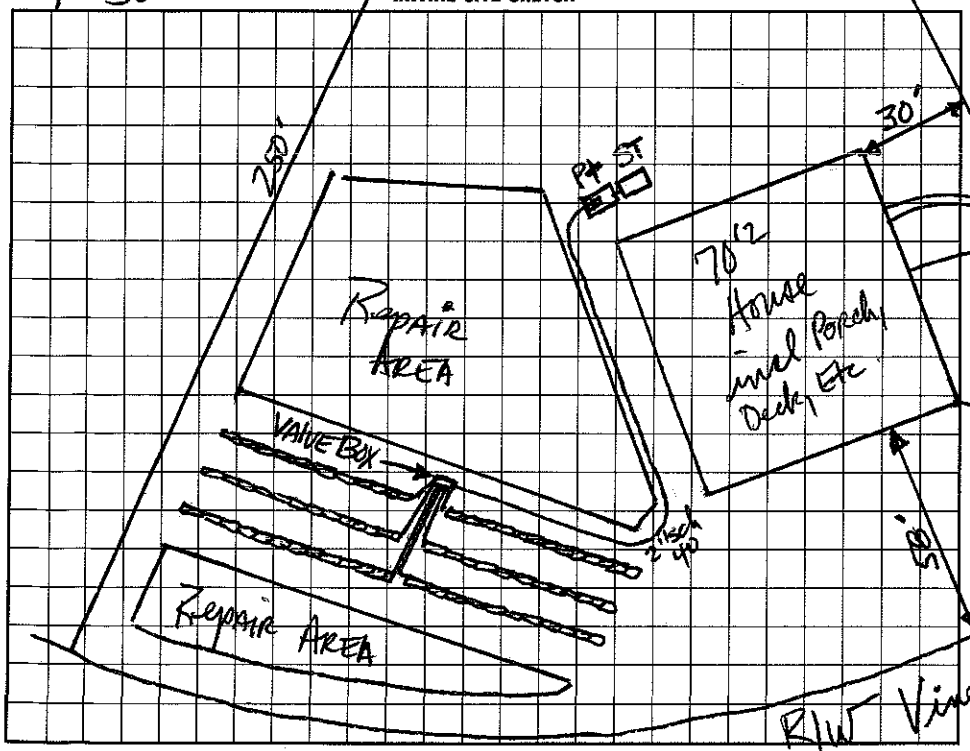

AS BUILT SKETCH

I understand that this permit can be suspended or revoked if any false information is supplied toward securing the permit/any unauthorized changes are made to the site/any unauthorized changes are made in the installation of the system. Improvement Permit with plat valid without expiration. Improvement Permit with site plan valid for sixty months. Authorization to Construct is valid for a period equal to that of Improvement Permit – not to exceed sixty months.

Signed: Paul C. Rogers date 8-20-98 Installed by: B & H Inc

Improvement Permit by: Donna R. Hinson, RS date 8-4-98 Operation Permit by: Maria H. Dobson date 6/12/2000

Authorization to Construct by: Donna R. Hinson, RS date 9-2-99 Existing System Inspection by: date

HEALTH DEPT. COPY: WHITE INSPECTION COPY (FINAL): GREEN OWNER COPY (FINAL): YELLOW INSPECTION COPY (INITIAL): PINK OWNER COPY (INITIAL): GOLD