IREDELL COUNTY HEALTH DEPARTMENT

STATESVILLE 704-878-5305 MOORESVILLE 704-664-5281

IMPROVEMENT PERMIT / AUTHORIZATION TO CONSTRUCT / OPERATION PERMIT / EXISTING SYSTEM INSPECTION

PERMIT# 071970 PIN# ~~4625-41-6884~~ 4635-04-4506 DATE July 25, '98

OWNER OR CONTRACTOR Crescent Resources Inc // Ashcraft Homes PHONE: Business _____ Home _____

ADDRESS PO Box 1008 Charlotte

LOCATION Brawley Sch Rd. TL The Pointe Dr. Queen Anne Circle to Easton Dr. 5th Lot on Right

SUBDIVISION The Pointe BLOCK / SECTION 1A LOT 6 LOT AREA 30,675 ft² SITE CLASS. RS DESIGN FLOW 460gpd L.T.A.R. ~.3

Septic Tank: 1000 Gallons; STB 338 Date 11-30-03

Pump Tank: 1000 Gallons; PT 27 Date 12-5-03

Pump Make: _____ Model _____ Serial No. _____

Nitrification Field: No. Fields 1 Square Feet 900 Linear Feet 300

No Lines 4 @ 60-90' Trench Width 36" Max Trench Bottom Depth ~30"

☑ New System ☐ Repair System Type: I, II, III, (IV) V, VI

System Description: LP Panel Block

Repair System Description: LP Panel Block

Maintenance Agreement Required: ☑ Yes ☐ No

Gravel Depth NA

☑ House/Mod. Home No. Bedrooms 4

☐ Mobile Home No. Bathrooms 4

☐ Business No. Employees _____

☐ Other _____

☐ Slab ☑ Crawl Space ☐ Basement w/plumbing ☐ Basement wo/plumbing


Water Supply: ☐ Individual ☒ Public ☐ Community

Comments:/Conditions: Septic System Installer to follow MATERIAL Specifications in The Pointe Wastewater Disposal Manual. Remove old Burms / TERRACES. Anti-Siphon Hole Required in pump tank. Pipe off Gutter Drains. Provide good stormwater diversion by Ditching / Burms Along side prop. LINES

Comments:/Conditions: Checked lines 1/2/03 MD
Installed 1-60' line & 3-80' lines
Checked tanks 1/7/04
Checked pressure elect & alarm 3/17/04

1"=50'

INITIAL SITE SKETCH

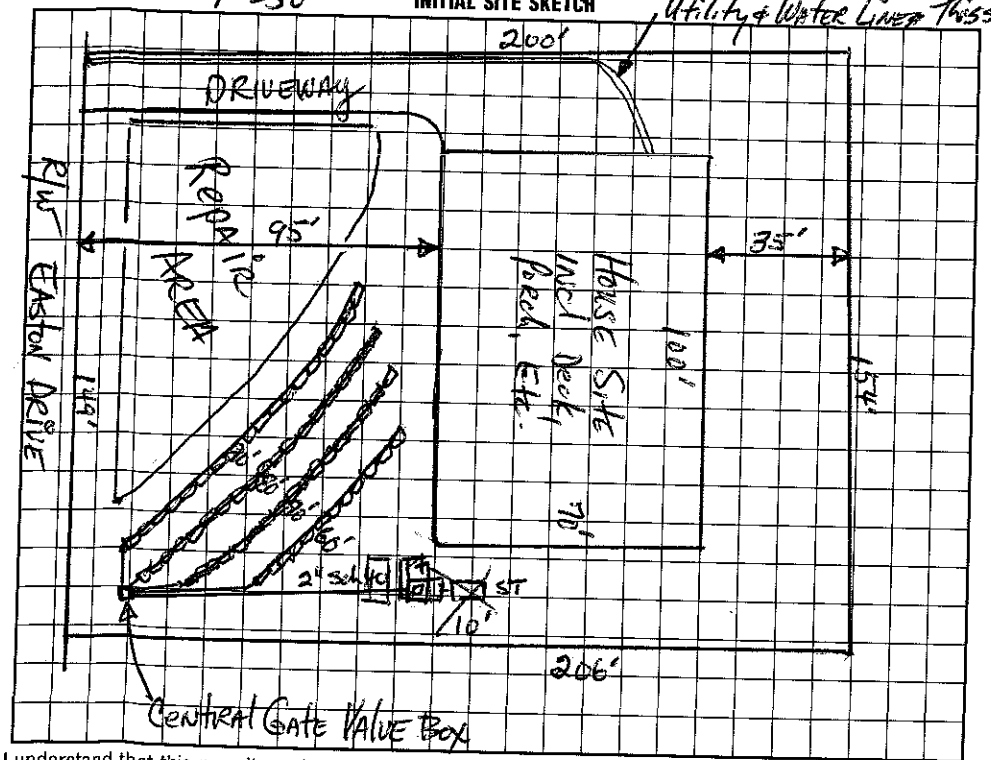

AS BUILT SKETCH

I understand that this permit can be suspended or revoked if any false information is supplied toward securing the permit/any unauthorized changes are made to the site/any unauthorized changes are made in the installation of the system. Improvement Permit with plat valid without expiration. Improvement Permit with site plan valid for sixty months. Authorization to Construct is valid for a period equal to that of Improvement Permit – not to exceed sixty months.

Signed: _____

Improvement Permit by: _____ date 8-2-98

Authorization to Construct by: _____ date 7-25-98

date 3-5-03

Installed by: R & H Inc RS

Operation Permit by: _____ date 3/18/04

Existing System Inspection by: _____ date _____

HEALTH DEPT. COPY: WHITE INSPECTION COPY (FINAL): GREEN OWNER COPY (FINAL): YELLOW INSPECTION COPY (INITIAL): PINK OWNER COPY (INITIAL): GOLD