IREDELL COUNTY HEALTH DEPARTMENT

STATESVILLE 704-878-5305 MOORESVILLE 704-664-5281

IMPROVEMENT PERMIT / AUTHORIZATION TO CONSTRUCT / OPERATION PERMIT / EXISTING SYSTEM INSPECTION

PERMIT# 071651 PIN# 462594684 4635-04-4832 DATE Aug 18, '98

OWNER OR CONTRACTOR Crescent Resources dba // LN Signature Homes PHONE: Business _____ Home _____

ADDRESS P.O. Box 1003 Charlotte

LOCATION Brawley School Rd. TL The Pointe DR. Queen Anne Circle to Easton DR. on left

SUBDIVISION The Pointe BLOCK / SECTION 1A LOT 120 LOT AREA 33,788 ft² SITE CLASS. PS DESIGN FLOW 480 gpd L.T.A.R. n.3

Septic Tank: 1000 Gallons; STB 338 Date 4/8/00
Pump Tank: 1000 Gallons; PT 27 Date 12/29/99
Pump Make: MYERS & HOS Model ME3 F8/99 Serial No. _____
Nitrification Field: No Fields 1 Square Feet 900 Linear Feet 300
No Lines 5@60' Trench Width 36" Max Trench Bottom Depth 30" Gravel Depth NA

☑ New System ☐ Repair System Type: I, II, III, (IV) V, VI
System Description: LP Gravel Block
Repair System Description: LP Gravel Block
Maintenance Agreement Required: ☑ Yes ☐ No

☑ House/Mod. Home No. Bedrooms 4
☐ Mobile Home No. Bathrooms 4
☐ Business No. Employees _____
☐ Other _____


☐ Slab ☑ Crawl Space ☐ Basement w/plumbing ☐ Basement wo/plumbing

Water Supply:
☐ Individual
☑ Public
☐ Community


Comments:/Conditions: Gullied AREAS must be properly filled. Remove any old burns, TERRACES. Do not grade drainfield areas.

Comments:/Conditions: 4-8-99 Reviewed home & revised site plan - appears in compliance w/ I.P. Staff

INITIAL SITE SKETCH

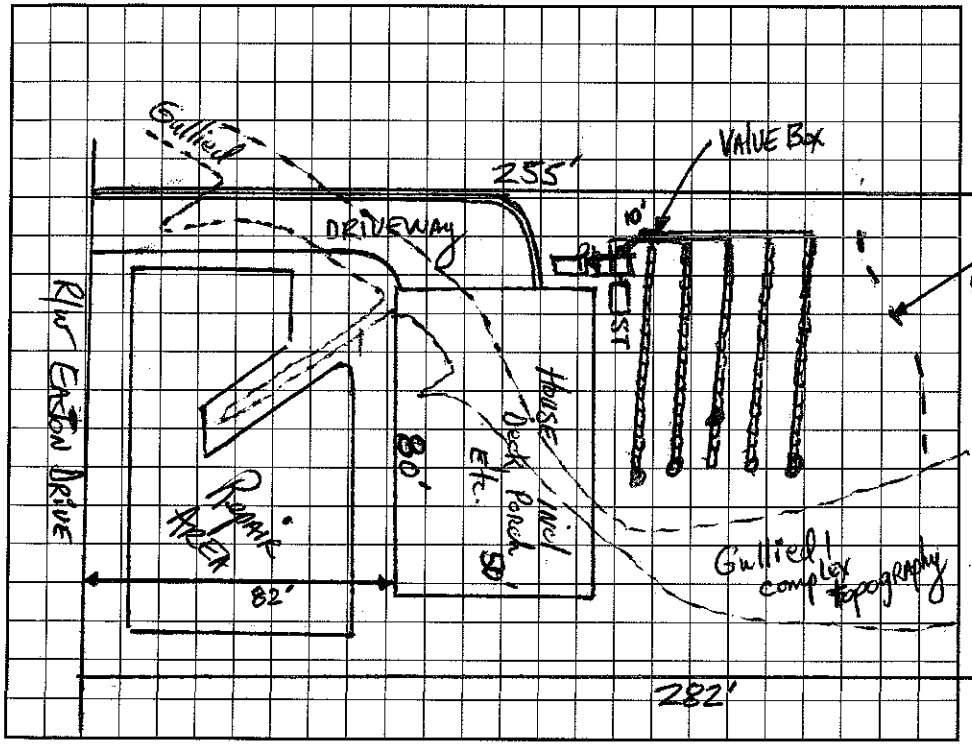

AS BUILT SKETCH

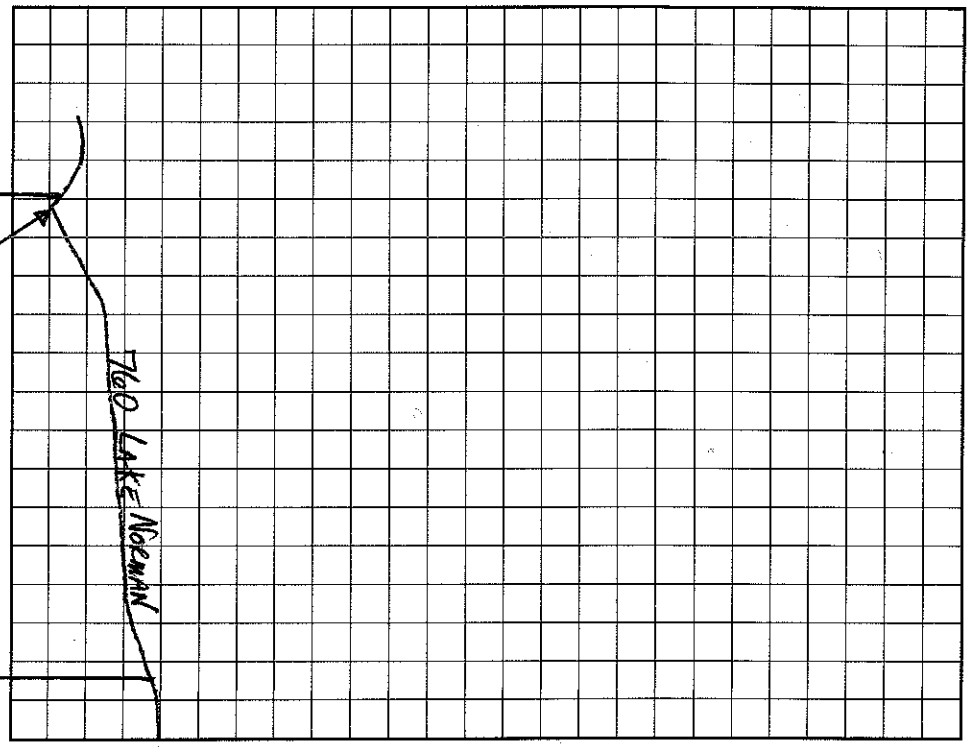

I understand that this permit can be suspended or revoked if any false information is supplied toward securing the permit/any unauthorized changes are made to the site/any unauthorized changes are made in the installation of the system. Improvement Permit with plat valid without expiration. Improvement Permit with site plan valid for sixty months. Authorization to Construct is valid for a period equal to that of Improvement Permit – not to exceed sixty months.

Signed: _____ date 8-7-98 Installed by: R & H

Improvement Permit by: _____, RS date 8-18-98

Authorization to Construct by: _____, RS date 4-8-99 Operation Permit by: _____, RS. date 3/22/00

Existing System Inspection by: _____ date _____

HEALTH DEPT. COPY: WHITE INSPECTION COPY (FINAL): GREEN OWNER COPY (FINAL): YELLOW INSPECTION COPY (INITIAL): PINK OWNER COPY (INITIAL): GOLD