IREDELL COUNTY HEALTH DEPARTMENT

STATESVILLE 704-878-5305 $150 MOORESVILLE 704-664-5281

IMPROVEMENT PERMIT / AUTHORIZATION TO CONSTRUCT / OPERATION PERMIT / EXISTING SYSTEM INSPECTION

PERMIT# 130949 PIN# 4635 04 5252 4635-04-5232 DATE 2/20/06

OWNER OR CONTRACTOR James R. Davidson PHONE: Business Home

ADDRESS 11908 Cupworth Ct. Huntersville NC 28078

LOCATION BSR, around circle to Point Dr., TL Queen Anne, TL Vineyard, on corner with Edgar town ct

SUBDIVISION Point BLOCK / SECTION 1-A LOT 48 LOT AREA 0.82 AC SITE CLASS. PS DESIGN FLOW 480 L.T.A.R. 0.3

Septic Tank: 1500 Gallons; STB 444 Date 3/24/06
Pump Tank: Gallons; PT Date
Pump Make: Model Serial No.
Nitrification Field: No Fields 1 Square Feet 1200 Linear Feet 400
No Lines 4 Trench Width 36" Max Trench Bottom Depth 36" Gravel Depth —

☒ New System ☐ Repair System Type: I (II) III, IV, V, VI
System Description: Grav. w/ 25% Reduction
Repair System Description: LP Panel Block
Maintenance Agreement Required: ☐ Yes ☒ No

☒ House/Mod. Home No. Bedrooms 4
☐ Mobile Home No. Bathrooms
☐ Business No. Employees
☐ Other

☐ Slab ☒ Crawl Space ☐ Basement w/plumbing ☐ Basement wo/plumbing


Water Supply: ☐ Individual ☐ Public ☒ Community

Comments:/Conditions:


1"=50'

Comments:/Conditions: Pike Electric damaged Lowest Line
- Orbison repaired Line 8/25/06

INITIAL SITE SKETCH

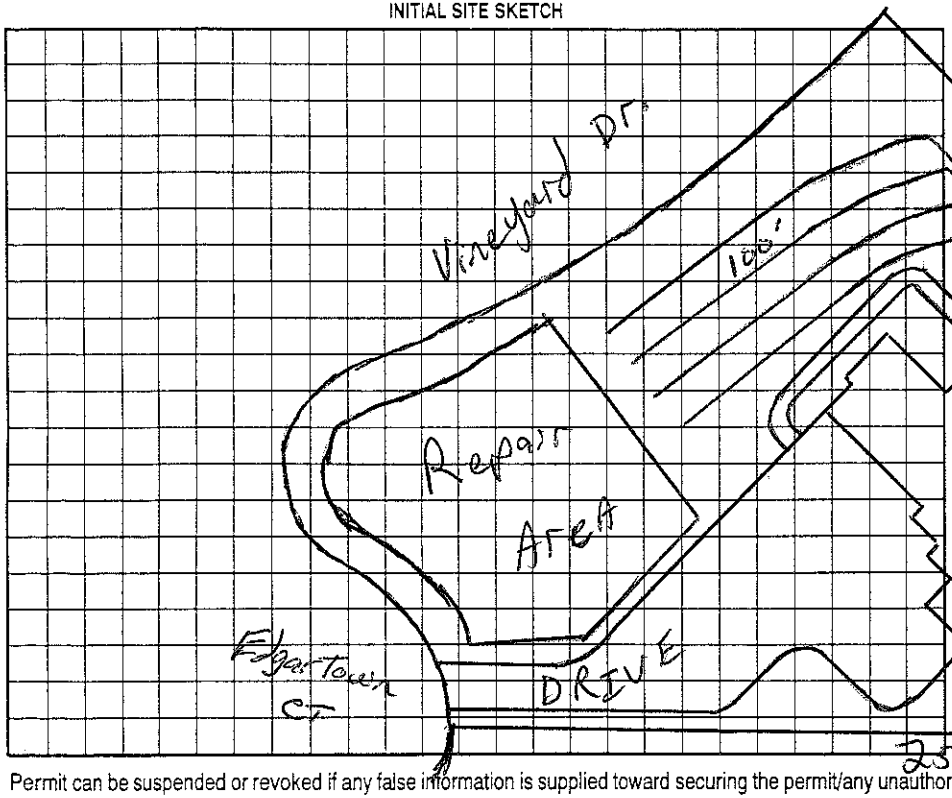

AS BUILT SKETCH

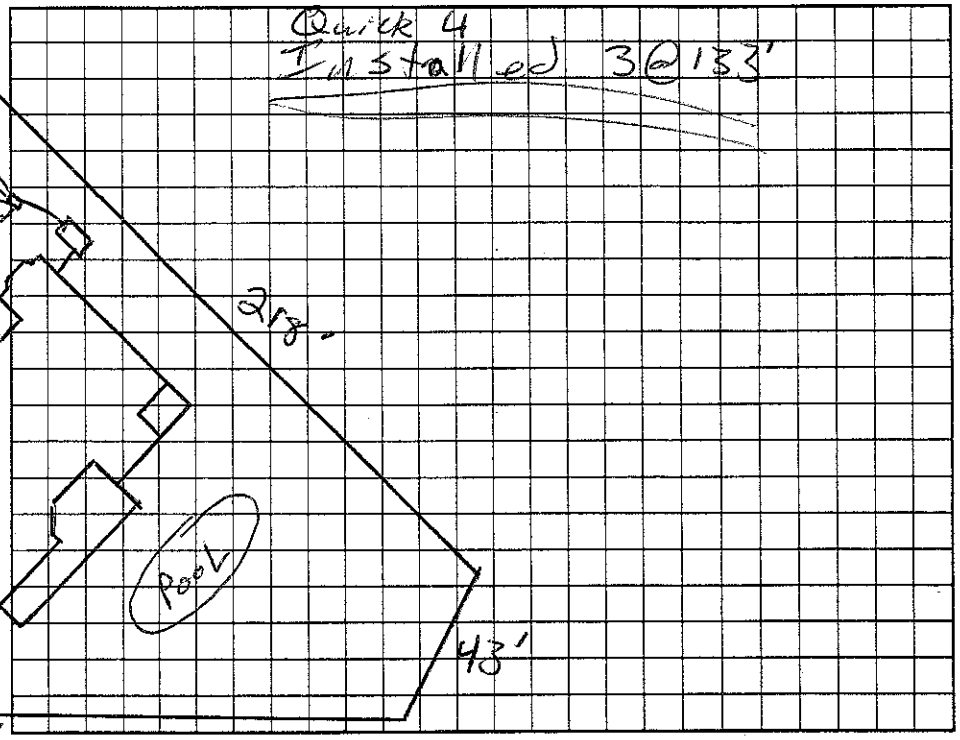

Permit can be suspended or revoked if any false information is supplied toward securing the permit/any unauthorized changes are made to the site/any unauthorized changes are made in the installation of the system. Improvement Permit with plat valid without expiration. Improvement Permit with site plan valid for sixty months. Authorization to Construct is valid for a period equal to that of Improvement Permit – not to exceed sixty months.

Signed: James Davidson date 2/20/06 Installed by: Orbison

Improvement Permit by: RS date 2/20/06 Operation Permit by: RS date 8/11/06

Authorization to Construct by: RS date 2/20/06 Existing System Inspection by: date

HEALTH DEPT COPY: WHITE OWNER COPY (FINAL): YELLOW OWNER COPY (INITIAL): PINK