IREDELL COUNTY HEALTH DEPARTMENT

STATESVILLE 704-878-5305 MOORESVILLE 704-664-5

IMPROVEMENT PERMIT / AUTHORIZATION TO CONSTRUCT / OPERATION PERMIT / EXISTING SYSTEM INSPECTION

PERMIT# 073398 PIN# 4625941684 4635-04-6275 DATE May 24, '99

OWNER OR CONTRACTOR Crescent Resources obo / Simonini Builders PHONE: Business 358-9940 Home

ADDRESS 2214 Brawley Sch Rd, Mooresville / 817 E. Morehead, Suite 100 Charlotte

LOCATION Brawley Sch Rd. to The Point DR. Queen Anne Circle to Vineyard DR. to Edgartown Ct.

SUBDIVISION The Point BLOCK / SECTION 1A LOT 47 LOT AREA 31,785 SF SITE CLASS. PS DESIGN FLOW 480 gpd L.T.A.R. .25-.3

Septic Tank: 1500 Gallons; STB 797 Date 7/4/99
Pump Tank: 1000 Gallons; PT 27 Date 8/23/99
Pump Make: MYERS Model ME 505-21 Serial No. 6199
Nitrification Field: No Fields 1 Square Feet 900 Linear Feet 300
No Lines 6 @ 50' Trench Width 36" Max Trench Bottom Depth ~30" Gravel Depth NA

☑ New System ☐ Repair System Type: I, II, III, (IV) V, VI
System Description: LP Panel Block
Repair System Description: Same
Maintenance Agreement Required: ☑ Yes ☐ No


☑ House/Mod. Home No. Bedrooms 4
☐ Mobile Home No. Bathrooms 4
☐ Business No. Employees
☐ Other
☐ Slab ☑ Crawl Space ☐ Basement w/plumbing ☐ Basement wo/plumbing

Water Supply: ☐ Individual ☑ Public ☐ Community

Comments/Conditions: Reduced / upgraded to type 4 to meet specifications set by CRC and Iredell County W.W. Dept.

Comments/Conditions:

INITIAL SITE SKETCH

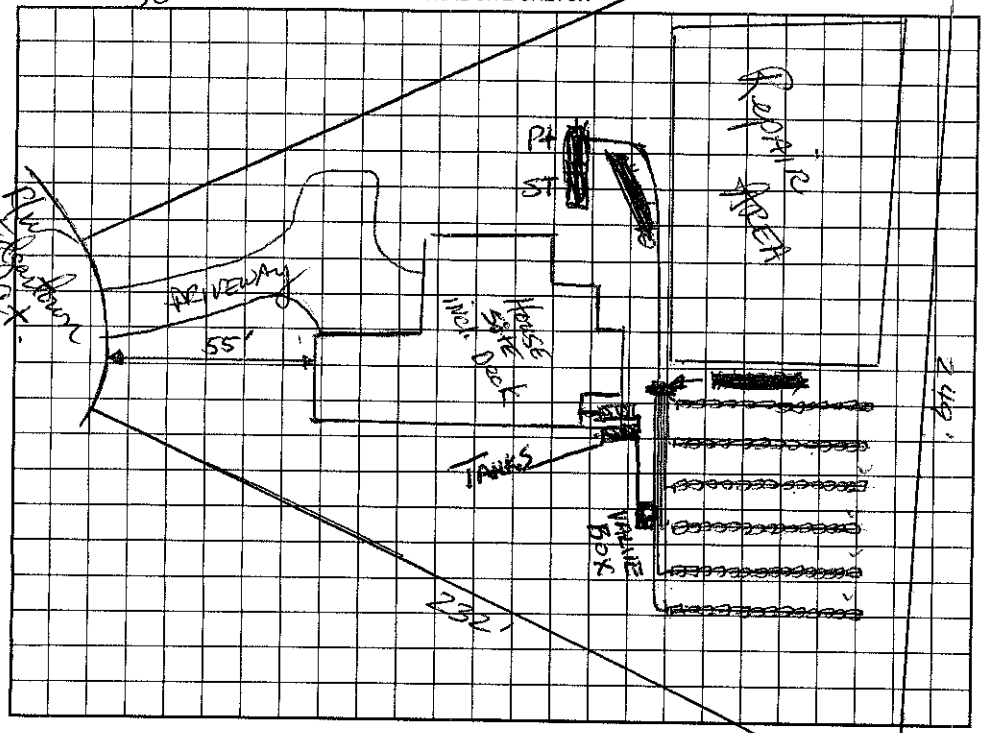

AS BUILT SKETCH

Permit can be suspended or revoked if any false information is supplied toward securing the permit/any unauthorized changes are made to the site/any unauthorized changes are made in the installation of the system. Improvement Permit with plat valid without expiration. Improvement Permit with site plan valid for sixty months. Authorization to Construct is valid for a period equal to that of Improvement Permit – not to exceed sixty months.

Signed: _____ date 5-24-99

Improvement Permit by: Derek R. Hanson, RS date 5-24-99

Authorization to Construct by: Derek R. Hanson, RS date 5-24-99

Installed by: R+H Line. [illegible]

Operation Permit by: Wesley Sparks RS. date 12/21/99

Existing System Inspection by: _____ date _____

HEALTH DEPT. COPY: WHITE OWNER COPY (FINAL): YELLOW OWNER COPY (INITIAL): PINK