# IREDELL COUNTY HEALTH DEPARTMENT

STATESVILLE 704-878-5305 MOORESVILLE 704-664-5281

## IMPROVEMENT PERMIT / AUTHORIZATION TO CONSTRUCT / OPERATION PERMIT / EXISTING SYSTEM INSPECTION

PERMIT# 073395 PIN# 4625944684 4635-04-8038 DATE Aug 1, '98

OWNER OR CONTRACTOR Crescent Resources Inc - Hughs Hamilton PHONE: Business _____ Home _____

ADDRESS PO Box 1003, Charlotte 28201

LOCATION Brawley School Rd. To The Pointe DR. Queen Anne Circle to Vineyard DR. to Edgetown Ct.

SUBDIVISION The Pointe BLOCK / SECTION 1A LOT 45 LOT AREA 33,759 SITE CLASS. PS DESIGN FLOW 480gpd L.T.A.R. .25

Septic Tank: ~~1000~~ 500 Gallons; STB 338 Date 3-29-02

Pump Tank: 1000 Gallons; PT 283 Date 3-18-02

Pump Make: Myers Model ME3F-21 Serial No. 2-02

Nitrification Field: No Fields 1 Square Feet 960 Linear Feet 320

No Lines 4@80' Trench Width 36" Max Trench Bottom Depth 30" Gravel Depth NA

☑ New System ☐ Repair System Type: I, II, III, IV, V, VI

System Description: LP Panel Block

Repair System Description: LP Panel Block

Maintenance Agreement Required: ☑ Yes ☐ No

☑ House/Mod. Home No. Bedrooms 4

☐ Mobile Home No. Bathrooms 4

☐ Business No. Employees _____

☐ Other _____

☐ Slab ☑ Crawl Space ☐ Basement w/plumbing ☐ Basement wo/plumbing


Water Supply: ☐ Individual ☑ Public ☑ Community

Comments:/Conditions: Remove any old Burms / Terraces

Comments:/Conditions: Installed filter Checked tanks & lines 5/8/02 Some Repair

1" = 50'

INITIAL SITE SKETCH

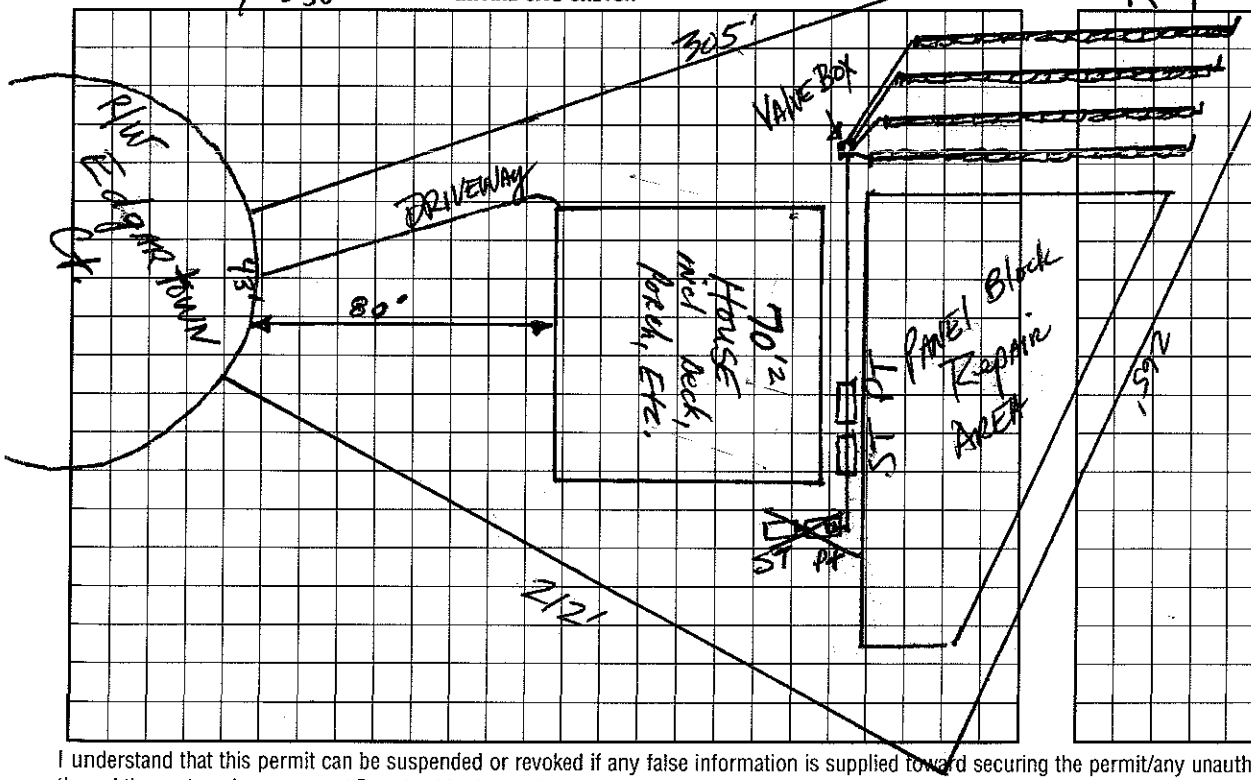


AS BUILT SKETCH

Installed 4 Panel Block lines @ 80' eq.

I understand that this permit can be suspended or revoked if any false information is supplied toward securing the permit/any unauthorized changes are made to the site/any unauthorized changes are made in the installation of the system. Improvement Permit with plat valid without expiration. Improvement Permit with site plan valid for sixty months. Authorization to Construct is valid for a period equal to that of Improvement Permit – not to exceed sixty months.

Signed: _____ date 8-20-98

Improvement Permit by: _____ date 8/1-98

Authorization to Construct by: _____ date 11/2/01

Installed by: Bobby Mayhew

Operation Permit by: _____ date 6/12/2002

Existing System Inspection by: _____ date _____

HEALTH DEPT. COPY: WHITE INSPECTION COPY (FINAL): GREEN OWNER COPY (FINAL): YELLOW INSPECTION COPY (INITIAL): PINK OWNER COPY (INITIAL): GOLD