# IREDELL COUNTY HEALTH DEPARTMENT

STATESVILLE 704-878-5305 MOORESVILLE 704-664-5281

## IMPROVEMENT PERMIT / AUTHORIZATION TO CONSTRUCT / OPERATION PERMIT / EXISTING SYSTEM INSPECTION

PERMIT# 142277 PIN# 4635048244 DATE 5-11-07

OWNER OR APPLICANT Arcadia Homes PHONE: Business 889-4663 Home WK 201-7181 Dan

ADDRESS P.O. Box 471941 Charlotte NC 28247

LOCATION Brawley School Rd TR Pointe Dr (after traffic Circle) TL Meeting Circle TL Vineyard

SUBDIVISION The Pointe BLOCK / SECTION 1A LOT 46 LOT AREA 40,065 ft² SITE CLASS. PS DESIGN FLOW 600gpd T.A.R. .3 TL Edgefield

Septic Tank: 1500 Gallons; STB 335 Date 12-24-07

Pump Tank: 1500 Gallons; PT 477 Date 10-1-07

Pump Make: Gould's Model WE0312M Serial No.

Nitrification Field: No Fields 1 Square Feet 1005' Linear Feet 335

No Lines 5 Trench Width As Per note Max Trench Bottom Depth 36"

☒ New System ☐ Repair ☐ Expansion System Type: I II III IV V VI

System Description: Pump-Lp-Panel Block

Repair System Description: Same

Maintenance Agreement Required: ☐ Yes ☐ No

☒ House/Mod. Home ☐ Mobile Home ☐ Business ☐ Other

No. Bedrooms 5 No. Persons ___ No. Employees ___


Water Supply: ☐ Individual ☒ Public ☒ Community

Gravel Depth N/A ☐ Gravity ☒ Pressure ☐ Slab ☒ Crawl Space ☐ Basement w/plumbing ☐ Basement wo/plumbing


Comments/Conditions: Note: Use trench width specified in Crescent Communities Manuel. 1/29/08 Checked tanks


Scale 1:50 INITIAL SITE SKETCH

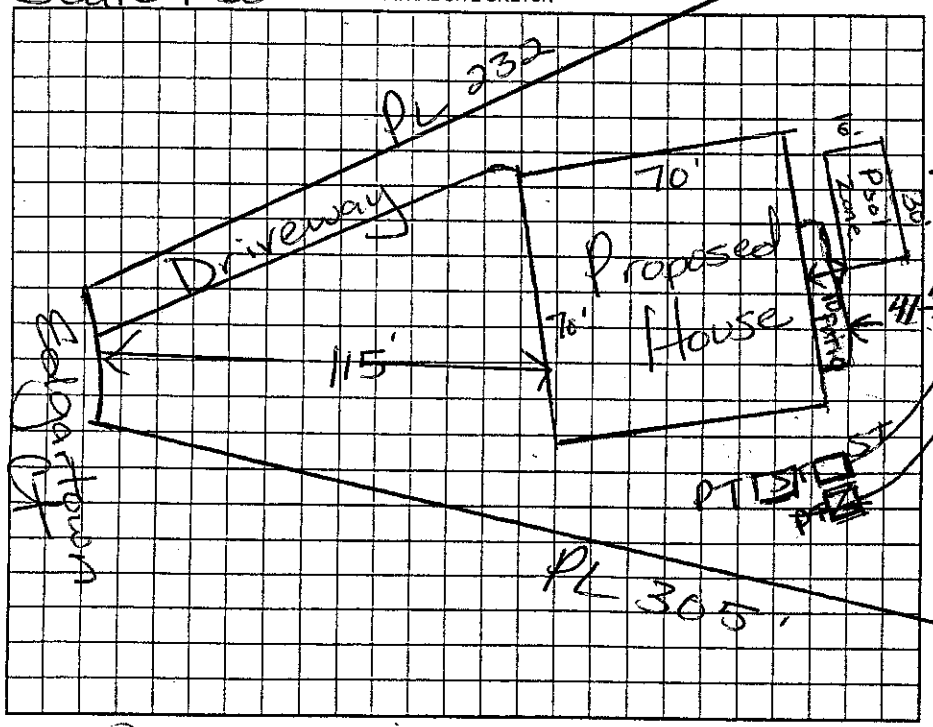


AS-BUILT SKETCH

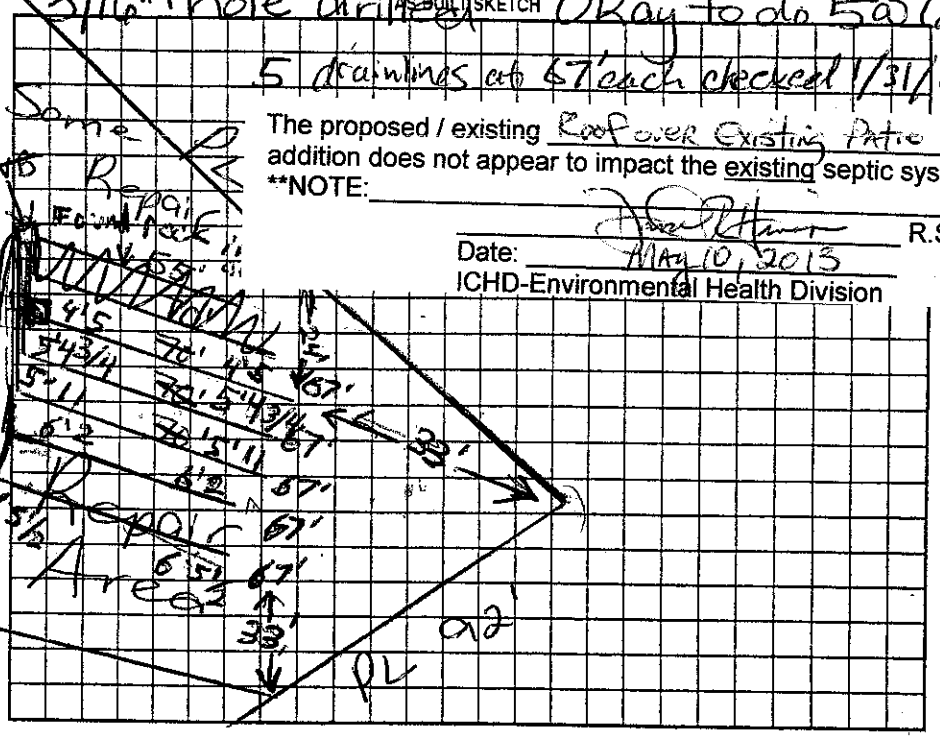


The proposed / existing Roof over Existing Patio addition does not appear to impact the existing septic system.

**NOTE:

R.S.

Date: May 10, 2013

ICHD-Environmental Health Division

Permit can be suspended or revoked if any false information is supplied toward securing the permit/any unauthorized changes are made to the site/any unauthorized changes are made in the installation of the system. Improvement Permit with plat valid without expiration ☐ Improvement Permit with site plan valid for sixty months ☐ Authorization to Construct is valid for a period equal to that of Improvement Permit – not to exceed sixty months.

Signed: [signature] date 3/18/07

Improvement Permit by: Maria H. Dotson RS date 5/11/07

Authorization to Construct by: Maria H. Dotson RS date 6/6/07

Installed by: R&F

Operation Permit by: Maria H. Dotson date 4/8/08

Existing System Inspection by: ___ date ___

HEALTH DEPT. COPY: WHITE OWNER COPY (FINAL): YELLOW OWNER COPY (INITIAL): PINK