IREDELL COUNTY HEALTH DEPARTMENT

STATESVILLE 704-878-5305 MOORESVILLE 704-664-5281

IMPROVEMENT PERMIT / AUTHORIZATION TO CONSTRUCT / OPERATION PERMIT / EXISTING SYSTEM INSPECTION

PERMIT# 142277 PIN# 4635048244 DATE 5-11-07

OWNER OR APPLICANT Arcadia Homes PHONE: Business 889-4663 Home UK 201-7181 Dan

ADDRESS P.O. Box 471941 Charlotte NC 28247

LOCATION Brawley School Rd TR Pointe Dr (after traffic circle) TL Meeting Circle TL Vineyard

SUBDIVISION The Pointe BLOCK / SECTION 1A LOT 46 LOT AREA 40,065 ft² SITE CLASS. PS DESIGN FLOW 600gpd T.A.R. .3 TL Edgartown

Septic Tank: 1500 Gallons; STB 338 Date 12-24-07

Pump Tank: 1500 Gallons; PT 477 Date 10-1-07

Pump Make: Gould's Model WE0312M Serial No.

Nitrification Field: No Fields 1 Square Feet 1005' Linear Feet 335'

No Lines 5 Trench Width ~~4'~~ See note Max Trench Bottom Depth 36" Gravel Depth N/A

☒ New System ☐ Repair ☐ Expansion System Type: I II III IV V VI

System Description: Pump-LP-Panel Block

Repair System Description: Same

Maintenance Agreement Required: ☐ Yes ☐ No

☒ House/Mod. Home No. Bedrooms 5

☐ Mobile Home No. Persons

☐ Business No. Employees

☐ Other

Water Supply: ☐ Individual ☒ Public ☒ Community


☐ Gravity ☒ Pressure ☐ Slab ☒ Crawl Space ☐ Basement w/plumbing ☐ Basement wo/plumbing

Comments/Conditions: Note: Use trench width specified in Crescent Communities Manual. 1/29/08 Checked tanks


Comments/Conditions: ~~4~~ Must keep Pool cut at least 15ft from Septic System. 6/6/07 Reviewed Floor plans, in Compliance with ID 3/16" hole drilled Okay to do 5a07. 5 drainlines at 67' each checked 1/31/08 A.C.

Scale 1:50

INITIAL SITE SKETCH

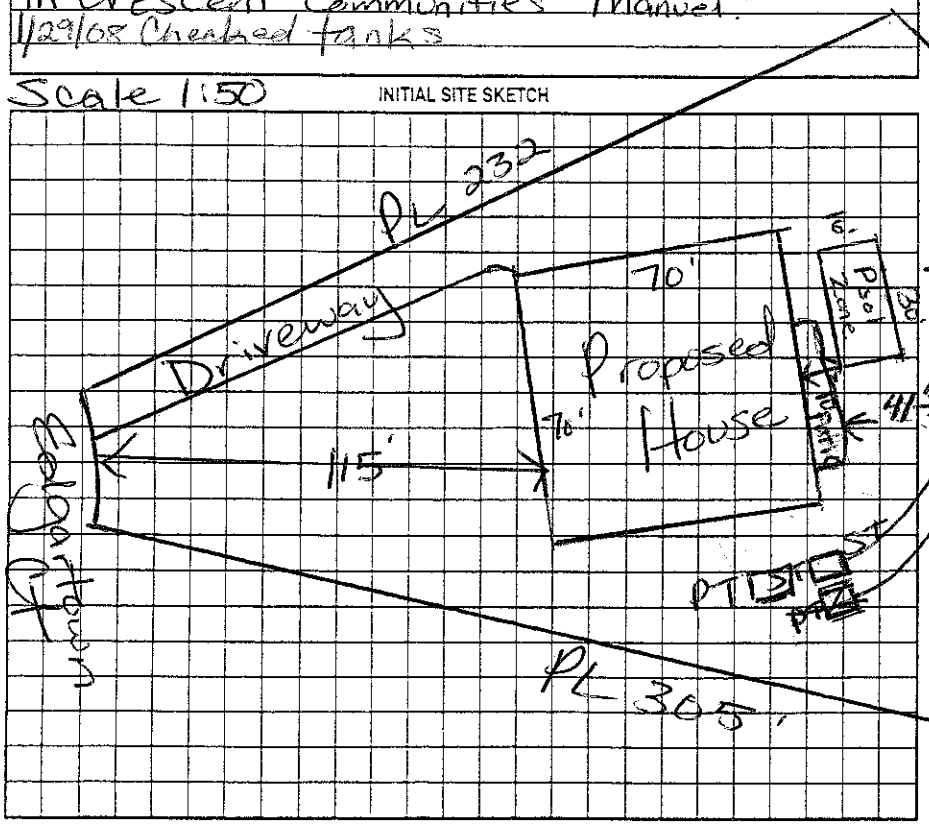

AS-BUILT SKETCH

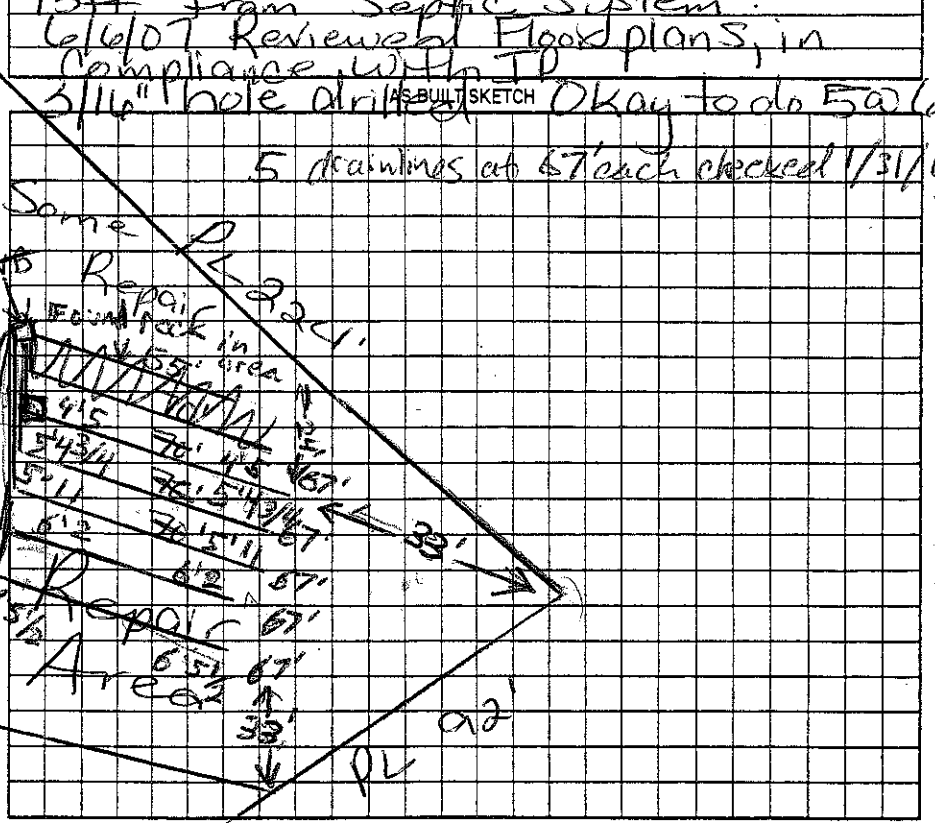

Permit can be suspended or revoked if any false information is supplied toward securing the permit/any unauthorized changes are made to the site/any unauthorized changes are made in the installation of the system. Improvement Permit with plat valid without expiration ☐ Improvement Permit with site plan valid for sixty months ☐ Authorization to Construct is valid for a period equal to that of Improvement Permit – not to exceed sixty months.

Signed: Monica L. Ramey date 3/8/07 Installed by: R & F

Improvement Permit by: Maria H. Dotson RS date 5/11/07 Operation Permit by: Maria H. Dotson date 4/8/08

Authorization to Construct by: Maria H. Dotson RS date 6/6/07 Existing System Inspection by: date

HEALTH DEPT. COPY: WHITE OWNER COPY (FINAL): YELLOW OWNER COPY (INITIAL): PINK