(-996.6330-)

COUNTY HEALTH DEPARTMENT

STATESVILLE 704-878-5305 MOORESVILLE 704-664-5281

IMPROVEMENT PERMIT / AUTHORIZATION TO CONSTRUCT / OPERATION PERMIT / EXISTING SYSTEM INSPECTION

Repair 3:00

Permit# Repair PIN# 4625941684 4635-04-8447 DATE 7/28/2000

OWNER OR CONTRACTOR Hughes & Assoc PHONE: Business 542-6816 Home Mike 361-5897

ADDRESS P.O. Box 31003 Charlotte, NC

LOCATION Brawley School Rd TL the Point Dr. TL Meeting House Circle TL Easton Dr 8th lot on Rt

SUBDIVISION The Pointe BLOCK / SECTION 1A LOT 9 LOT AREA 30,345ft² SOIL CLASS. PS DESIGN FLOW 450gpd L.T.A.R. .3

Septic Tank: 1500 Gallons; STB ____ Date ____

Pump Tank: 1000 Gallons; PT ____ Date ____

Pump Make: ____ Model ____ Serial No. ____

Nitrification Field: No Fields 1 Square Feet 600' Linear Feet 200'

No Lines 2 at 100' Trench Width 36" Max Trench Bottom Depth 36" Gravel Depth N/A

[X] New System [X] Repair System Type: I, II, (III), IV, V, VI

System Description: ____

Repair System Description: Grav 25% Reduction

Maintenance Agreement Required: ☐ Yes [X] No

[X] House/Mod. Home No. Bedrooms 4

☐ Mobile Home No. Bathrooms 4

☐ Business No. Employees ____

☐ Other ____


☐ Slab [X] Crawl Space ☐ Basement w/plumbing ☐ Basement wo/plumbing

Water Supply: ☐ Individual [X] Public [X] Community


Comments:/Conditions: Install "Drop Box" on last line of Initial Drainfield therefore overflow will go to New drainlines.

Comments:/Conditions: Note: If failure continues after "Repair lines" are installed then Irrigation will have to be eliminated. Extra fill will be added over lines.

INITIAL SITE SKETCH

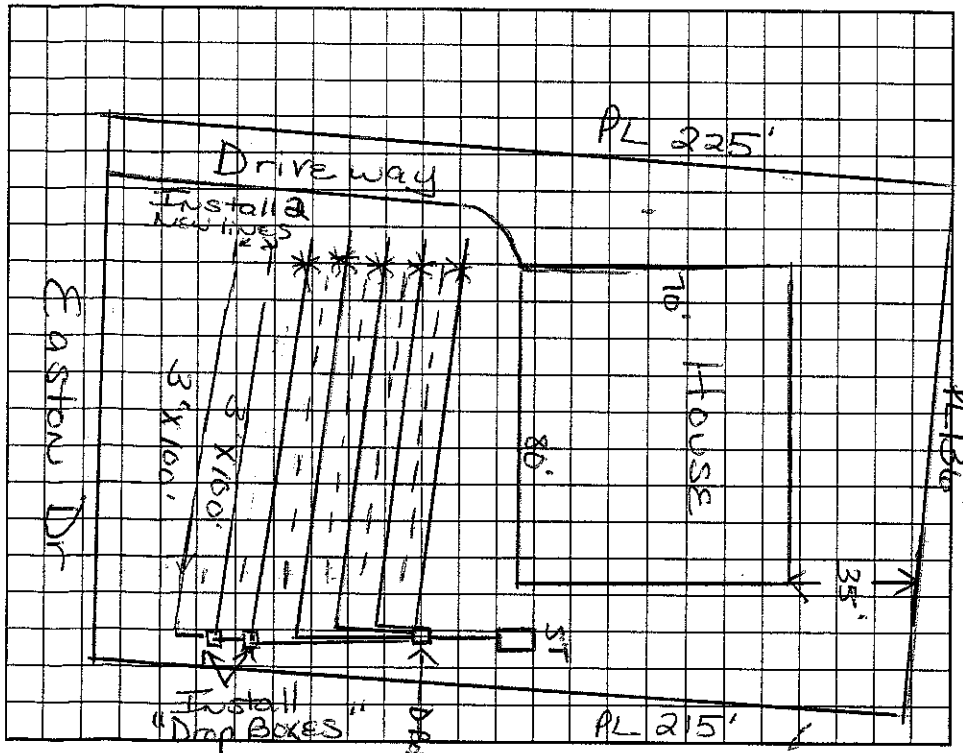

AS BUILT SKETCH

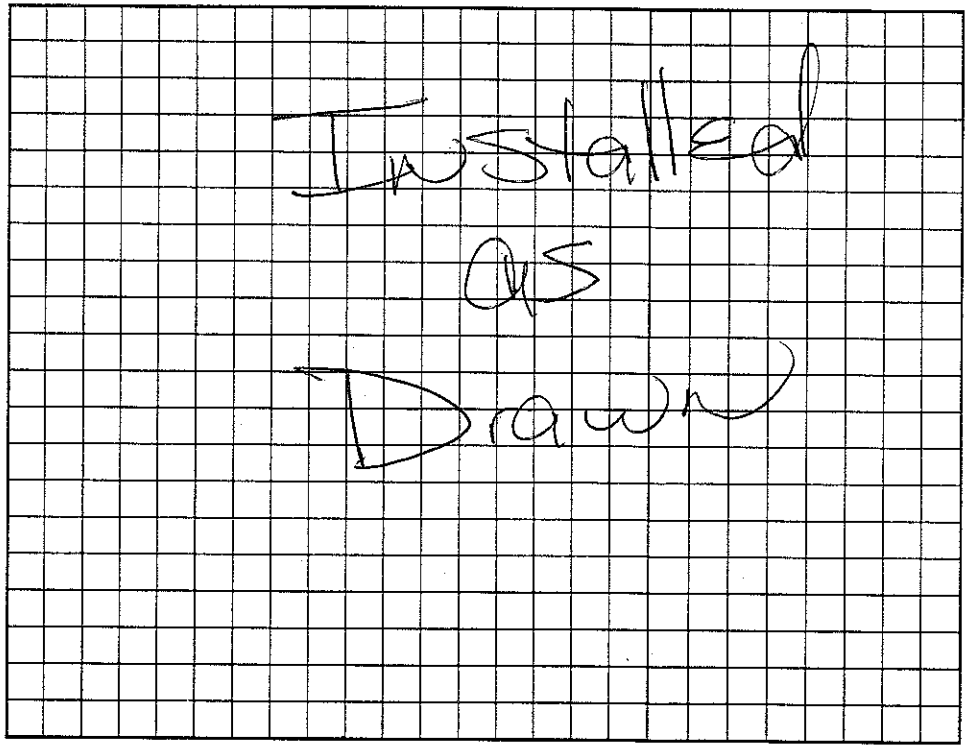

Permit can be suspended or revoked if any false information is supplied toward securing the permit/any unauthorized changes are made to the site/any unauthorized changes are made in the installation of the system. Improvement Permit with plat valid without expiration. Improvement Permit with site plan valid for sixty months. Authorization to Construct is valid for a period equal to that of Improvement Permit – not to exceed sixty months.

Signed: Michael S. Hughes date 7/28/00 Installed by: R & H

Improvement Permit by: Maria H. Dotson RS date 7/28/00 Operation Permit by: Maria H. Dotson RS date 8/9/2000

Authorization to Construct by: Maria H. Dotson RS date 7/28/00 Existing System Inspection by: ____ date ____

HEALTH DEPT. COPY: WHITE OWNER COPY (FINAL): YELLOW OWNER COPY (INITIAL): PINK

Need: D-Box & filter ~~Checked~~ 3:30

REDELL COUNTY HEALTH DEPARTMENT

STATESVILLE 704-878-5305 MOORESVILLE 704-664-5281

IMPROVEMENT PERMIT / AUTHORIZATION TO CONSTRUCT / OPERATION PERMIT / EXISTING SYSTEM INSPECTION

PERMIT# 071973 PIN# 4625941684 DATE July 25, 198

OWNER OR CONTRACTOR Crescent Resources Inc / Hughes & Assoc PHONE: Business Mike 361-5897 Mobile Home 542-6816

ADDRESS PO Box 1003 Charlotte

LOCATION Brawley Sch Rd. TL The Pointe Dr. Queen Anne Circle to Easton Drive 8th lot on Right

SUBDIVISION The Pointe BLOCK / SECTION 1A LOT 9 LOT AREA 30,345 ft² SITE CLASS. PS DESIGN FLOW 480gpd L.T.A.R. .3

Septic Tank: 1000/500 Gallons; STB 338 Date 8-23-99

Pump Tank: 1000 Gallons; PT Date

Pump Make: Model Serial No.

Nitrification Field: No. Fields 1 Square Feet 1200 Linear Feet 400

No. Lines 4@100' Trench Width 36" Max Trench Bottom Depth 36" Gravel Depth NA

☑ New System ☐ Repair System Type: I, II, III, IV, V, VI

System Description: Gravity 25% Reduction

Repair System Description: Gravity Pumped 25-50% Red.

Maintenance Agreement Required: ☐ Yes ☑ No

☑ House/Mod. Home No. Bedrooms 4

☐ Mobile Home No. Bathrooms 4

☐ Business No. Employees

☐ Other

☐ Slab ☑ Crawl Space ☐ Basement w/plumbing ☐ Basement wo/plumbing

Water Supply: ☐ Individual ~~☐ Public~~ ☐ Community

Comments:/Conditions: * ONE Inspection/observation port per Lateral. Remove old Burns/Terraces. Septic System installed to follow material specifications in The Pointe Wastewater Disposal Manual.

Comments:/Conditions:


9-15-99 Renewed house & site plan appears in compliance w/ I.P. DRH

Checked tanks & lines 4/27/2000 MD

Box & filter checked 5/4/00

1"=50'

INITIAL SITE SKETCH

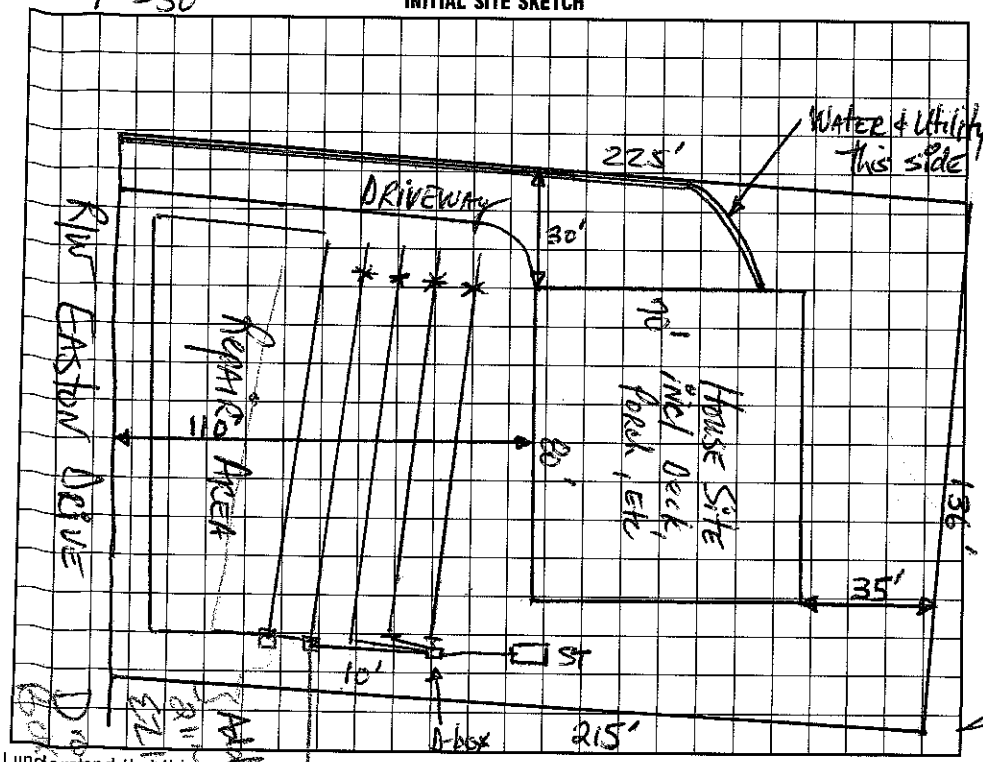

AS BUILT SKETCH

Installed as Drawn

Note: Divert Storm water around Drain Field

I understand that this permit can be suspended or revoked if any false information is supplied toward securing the permit/any unauthorized changes are made to the site/any unauthorized changes are made in the installation of the system. Improvement Permit with plat valid without expiration. Improvement Permit with site plan valid for sixty months. Authorization to Construct is valid for a period equal to that of Improvement Permit – not to exceed sixty months.

Signed: * Patti Pope date 8-2-98

Improvement Permit by: [illegible] RS date 7-25-98

Authorization to Construct by: [illegible] RS date 9-15-99

Installed by: R & H

Operation Permit by: Mark H. Dotson date 5/4/00

Existing System Inspection by: date

HEALTH DEPT. COPY: WHITE INSPECTION COPY (FINAL): GREEN OWNER COPY (FINAL): YELLOW INSPECTION COPY (INITIAL): PINK OWNER COPY (INITIAL): GOLD