...DEPARTMENT

STATESVILLE 704-878-5305 MOOR...

...T / AUTHORIZATION TO CONSTRUCT / OPERATION PERMIT / EXISTING ...

SECTION

OWNER OR CONTRACTOR Crescent Resources dba/ Hughes & Assoc PIN# 4625941684 (Lot) 4635-04-8738 DATE 10/14/99

ADDRESS PHONE: Business Home

LOCATION Brawley Sch. Rd. Turn on The Point Drive Meeting House Circle to Easton Drive on left

SUBDIVISION The Point BLOCK / SECTION I-A LOT 117 LOT AREA 36,697 sq.ft. SITE CLASS RS DESIGN FLOW 480gpd L.T.A.R. .3

Septic Tank: 1500+ Gallons; STB 338 Date 4-19-00
Pump Tank: 1000 Gallons; PT 283 Date 4-17-00
Pump Make: Model Serial No.
Nitrification Field: No Fields 1 Square Feet 1200+ Linear Feet 400+
No Lines 6 Trench Width 36" Max Trench Bottom Depth 36" Gravel Depth N/A

☑ New System ☐ Repair System Type: I, II, III, IV, V, VI
System Description: PM-Innovative-25%Red.
Repair System Description: SAME
Maintenance Agreement Required: ☐ Yes ☑ No

☑ House/Mod. Home No. Bedrooms 4
☐ Mobile Home No. Bathrooms 4
☐ Business No. Employees
☐ Other


☑ Slab ☑ Crawl Space ☑ Basement w/plumbing ☐ Basement wo/plumbing

Water Supply: ☐ Individual ☑ Public ☐ Community


Comments:/Conditions: Remove BB burns, terraces. Replaces permit issued 8-18-98.

Comments:/Conditions: ~~(Partial)~~ Inspected lines 1/4/2000 mp
EZ 1gal
Filter & riser installed.

INITIAL SITE SKETCH

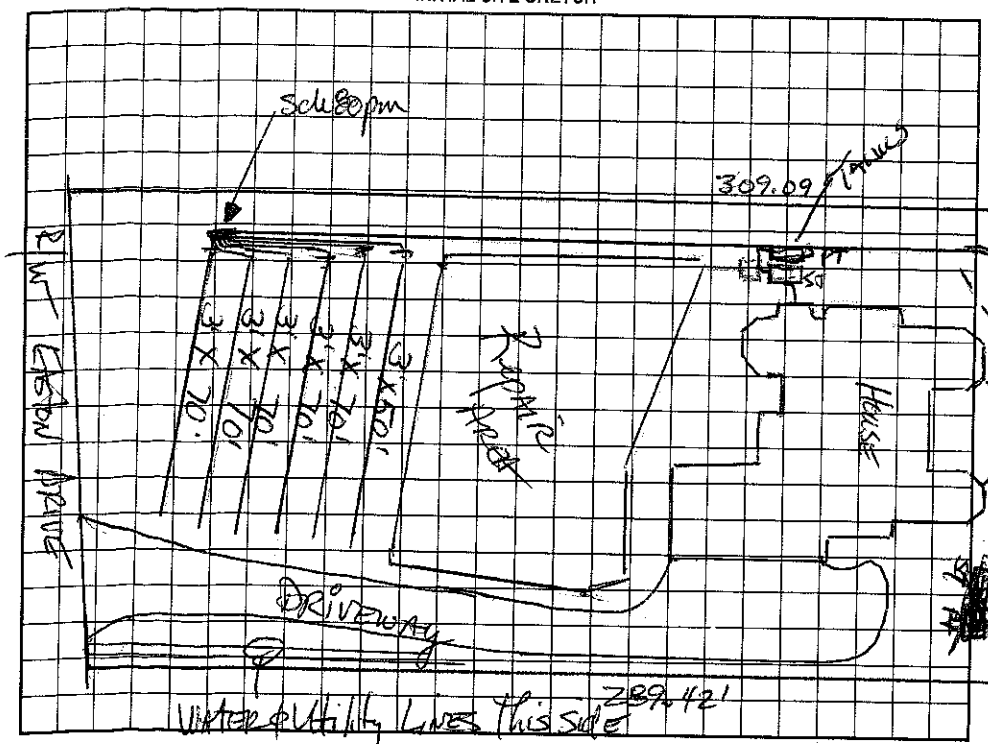

AS BUILT SKETCH

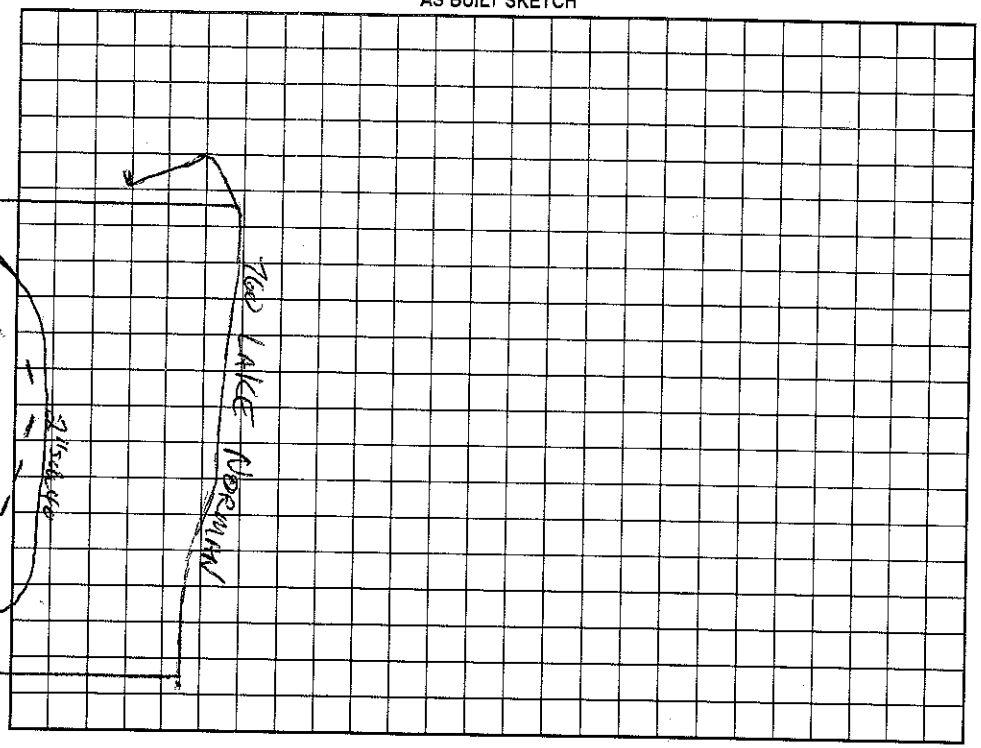

Permit can be suspended or revoked if any false information is supplied toward securing the permit/any unauthorized changes are made to the site/any unauthorized changes are made in the installation of the system. Improvement Permit with plat valid without expiration. Improvement Permit with site plan valid for sixty months. Authorization to Construct is valid for a period equal to that of Improvement Permit – not to exceed sixty months.

Signed: William H. Peplan date 10-19-99 Installed by: R & H Inc

Improvement Permit by: [signature], RS date 10-14-99 Operation Permit by: Wesley Sparks RS. date 10/25/00

Authorization to Construct by: [signature], RS date 10-14-99 Existing System Inspection by: date

HEALTH DEPT. COPY: WHITE OWNER COPY (FINAL): YELLOW OWNER COPY (INITIAL): PINK